DATE: 05/22/96 TIME: 10:09:09
DESIGN FILE: I:\ligo\site1\ar\wa427.d3z

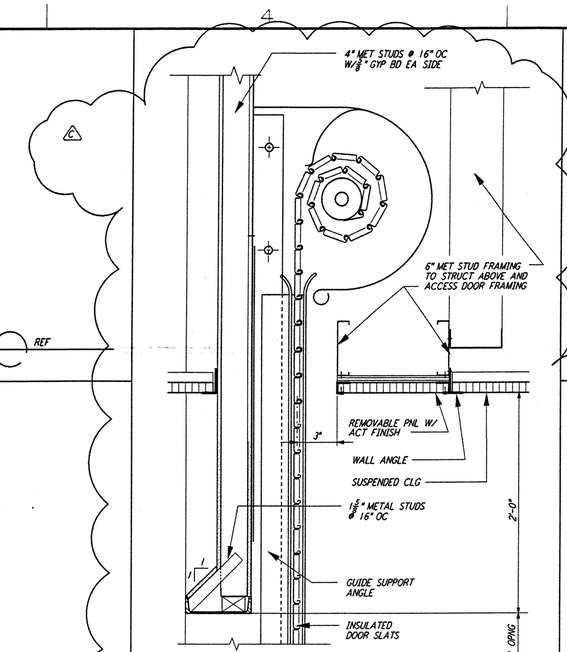

OVERHEAD COILING DOOR

1½"=1'-0"

7 / WA-A-427 — REF WA-A-261 SEE SPEC

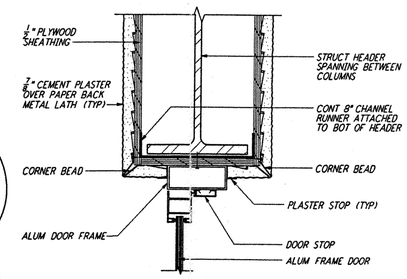

ALUMINUM DOOR HEAD

3" =1'-0"

4 / WA-A-427 — REF SEE SPEC

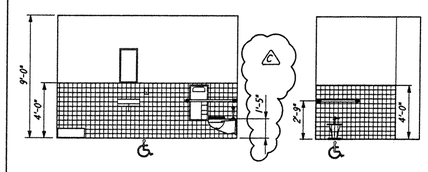

ELEVATION B

ELEVATION C

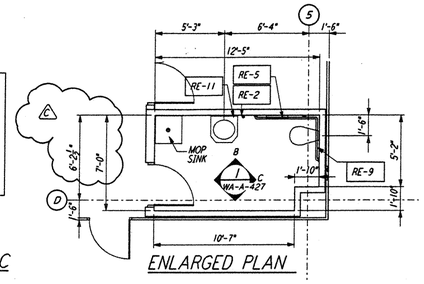

ENLARGED PLAN

TOILET 208

¼"=1'-0"

1 / WA-A-427 — REF WA-A-201

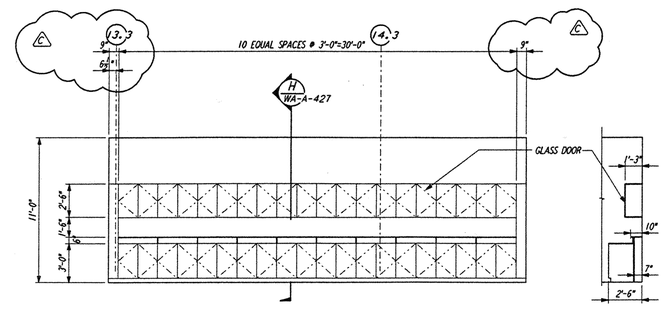

ELEVATION D

SECTION H

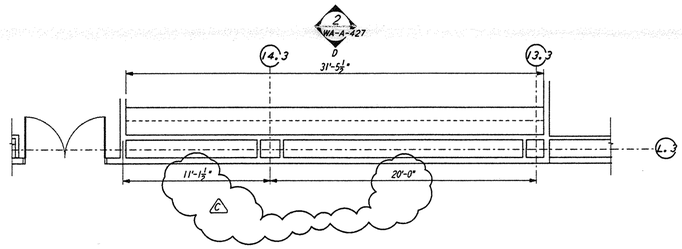

VACUUM PREP/ ASSEMBLY AREA (OSB)

¼"=1'-0"

166

2 / WA-A-427 — REF WA-A-109

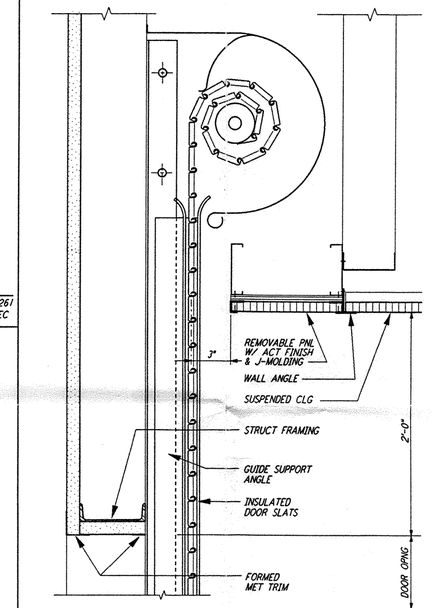

OVERHEAD COILING DOOR

1½"=1'-0"

5 / WA-A-427 — REF WA-A-261 SEE SPEC

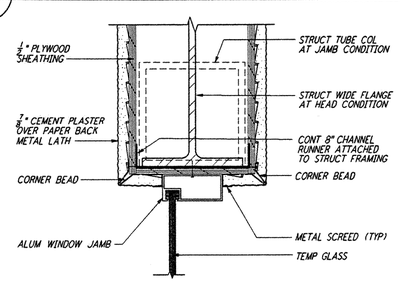

ALUM WDW HEAD (JMB SIM)

3" =1'-0"

3 / WA-A-427 SEE SPEC — REF

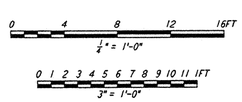

LIGO-D960271-C-O

This document and the design it covers are the property of **PARSONS**. They are loaned only with the borrower's expressed written agreement that they will not be reproduced, copied, loaned, exhibited, or used in any other way, except by written consent from **PARSONS** to the borrower.

REFERENCES

DRAWING NO.	DESCRIPTION

REVISIONS

NO.	DATE	BY	CHKD	ENGR	PROJ	DESCRIPTION
C	5-22-96	BK	BK	SF	TDM	BID ADDENDUM #2
B	4-19-96		SF	SF	TDM	FINAL DESIGN REVIEW & BID
A	01/17/96		SF	SF	TDM	PRELIMINARY DESIGN REVIEW

DRAWN	CKT
CHECKED	
ENGINEER	
PROJ	

PARSONS
100 WEST WALNUT STREET
PASADENA, CALIFORNIA

LIGO
CALIFORNIA INSTITUTE OF TECHNOLOGY
MASSACHUSETTS INSTITUTE OF TECHNOLOGY

LASER INTERFEROMETER
GRAVITATIONAL-WAVE OBSERVATORY
SITE NO. 1 - HANFORD, WASHINGTON

TITLE: ARCHITECTURAL INTERIOR ELEVATIONS & MISCELLANEOUS DETAILS

SCALE | CONTRACT NUMBER: PP150969 | PROJECT NUMBER: 8094

SHEET NUMBER: WA-A-427 | REVISIONS: C

LIGOWAF3.BDR

Wed May 22 10:08:14 1996 3.5"x32" J:\PLOTS\DWGS\VA2822\WA427.DWG