



AIR HANDLING UNIT STRUCTURE
FOUNDATION PLAN
 3/8" = 1'-0"

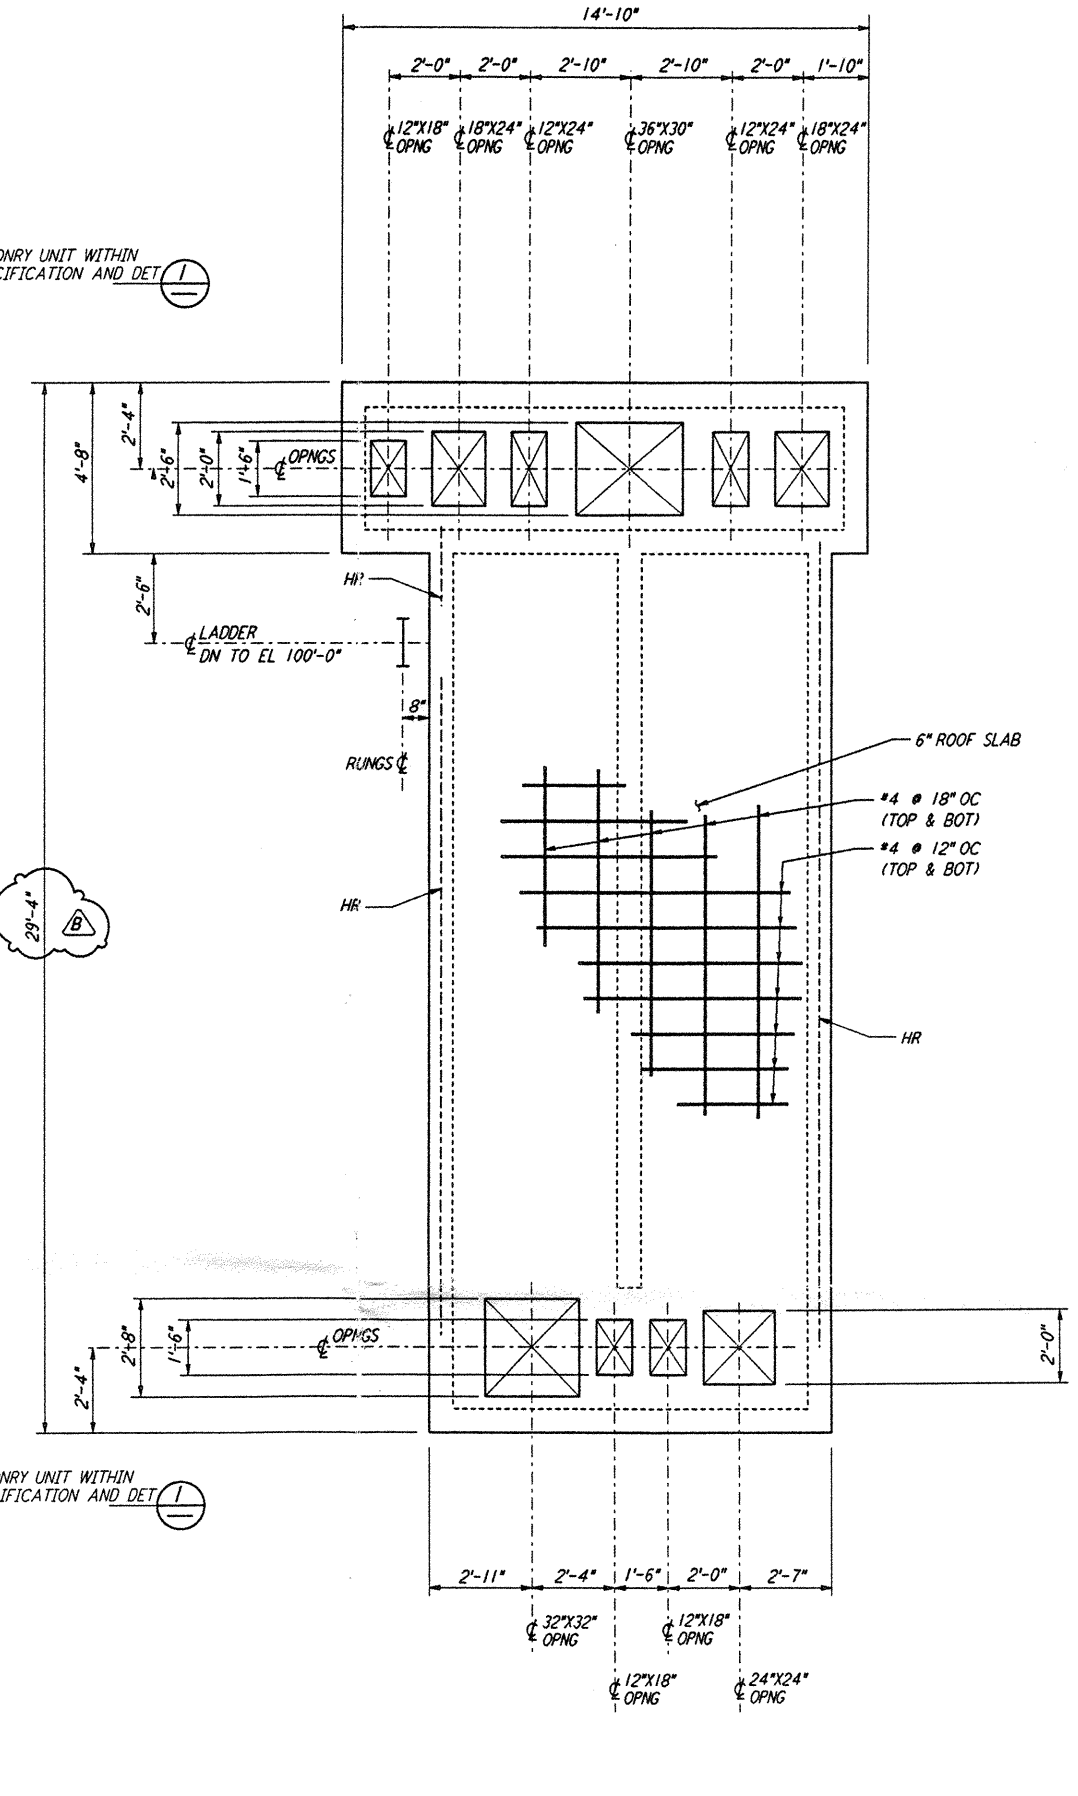


AIR HANDLING UNIT STRUCTURE
CONCRETE ROOF SLAB PLAN
 3/8" = 1'-0"

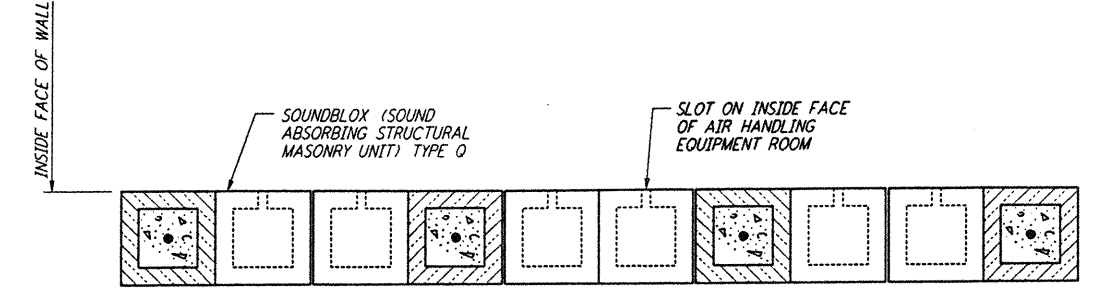

TYPICAL SECTION OF SOUNDBLOX MASONRY WALL
DETAIL
 1/2" = 1'-0"

NOTE:
 1. LOCATION AND SIZE OF ALL EQUIPMENT PADS ARE FOR BID PURPOSE ONLY. CONTRACTOR SHALL ADJUST TO SUIT ACTUAL EQUIPMENT AND SUBMIT DRAWINGS SHOWING ACTUAL SIZES AND LOCATIONS PRIOR TO CONSTRUCTION.

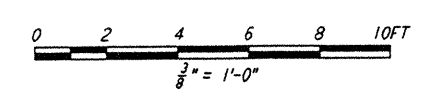

LIGO-D960308-B-0

NO.	DATE	BY	CHKD	ENGR	PROJ	DESCRIPTION
B	5-22-96	MCS	DDM	BP	TDM	BID ADDENDUM #2
A	4-19-96	MCS	DDM	BP	TDM	FINAL DESIGN REVIEW & BID

DRAWN	MCS
CHECKED	
ENGINEER	
PROJ	

PARSONS
 100 WEST WALNUT STREET
 PASADENA, CALIFORNIA

LIGO
 CALIFORNIA INSTITUTE OF TECHNOLOGY
 MASSACHUSETTS INSTITUTE OF TECHNOLOGY

LASER INTERFEROMETER
 GRAVITATIONAL-WAVE OBSERVATORY
 SITE NO. 1 - HANFORD, WASHINGTON

TITLE: STRUCTURAL MID & END STATIONS AIR HANDLING UNIT ENCLOSURE PLANS
 SCALE: AS NOTED
 CONTRACT NUMBER: PPI50969
 PROJECT NUMBER: 8094
 SHEET NUMBER: **WA-S-202**

This document and the design it covers are the property of PARSONS. They are loaned only with the borrower's expressed written agreement that they will not be reproduced, copied, loaned, exhibited, or used in any other way, except by written consent from PARSONS to the borrower.

Non Mod 20 126/130 1370 5374002 JV\ELUIS\BUREAU\B3\3\1262.PIC

Non Mod 20 126/130 1416 5374002 JV\ELUIS\BUREAU\B3\3\1262.PIC