DATE: 09/03/98 TIME: 17:38:47
DESIGN FILE: I:\ligo\site1\st\was403.dgz

not be reproduced, copied, loaned, exhibited, or used in any other way, except by written consent from PARSONS.

This document and the design it covers are the property of PARSONS. They are loaned only with the borrower's expressed written agreement that they will

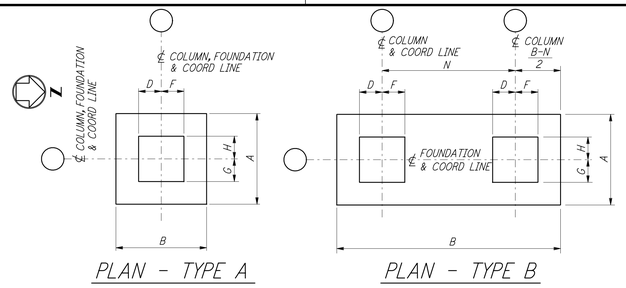

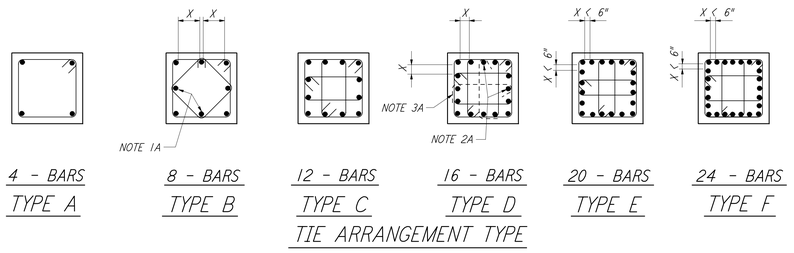

TIE REINFORCEMENT NOTES:

1A. THESE BARS MUST BE TIED AS SHOWN BY DASHED LINES WHEN X DISTANCE IS OVER 6 INCHES.
2A. THESE BARS NEED NOT BE TIED WHEN X DISTANCE IS 6 INCHES OR LESS.
3A. ALTERNATE 90° HOOKS IN COLUMNS.

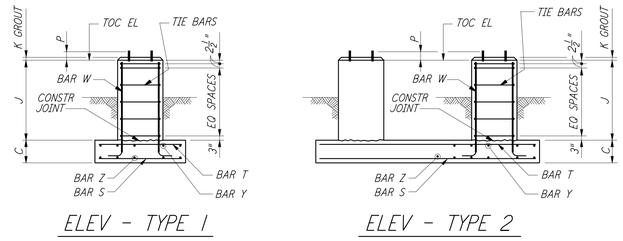

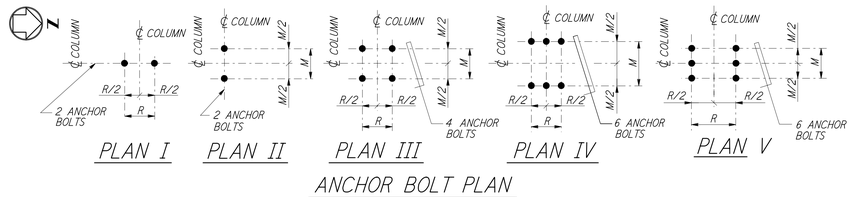

NOTES:

1. CONSTRUCTION SHALL COMPLY WITH ALL THE REQUIREMENTS OF THE GENERAL NOTES ON DRAWING WA-S-001.
2. THE BAR SPACING IS BASED ON CENTER TO CENTER OF TIE SET.
3. FOR ANCHOR BOLT DETAILS SEE DRAWING WA-S-003.

FOUNDATION NO OF FDNS REQD	FOUNDATION LOCATION (COL LINES)	TOP OF CONC EL	FOUNDATION TYPE PLAN	FOUNDATION TYPE ELEV	DIMENSIONS A	B	C	D	F	G	H	J	K	M	R	N	ANCHOR BOLTS PER PIER ANCHOR BOLT PLAN	TYPE	NO PER PIER	SIZE Ø	L	P	REINFORCING PER FOUNDATION BAR S NO	SIZE	BAR Z NO	SIZE	BAR T NO	SIZE	BAR Y NO	SIZE	BAR W NO	SIZE	TIE BAR TYPE	SIZE	NO REQD	CONC CY	FDN LOC PLAN	REMARKS
OSB - CORNER STATION																																							
1	V-18	100'-0"	B	2	4'-0"	9'-0"	1'-6"	10"	10"	10"	10"	1'-2"	1"	7"	7"	5'-0"	III	2	4	1"	1'-4"	4"	5	#6	10	#6	5	#6	10	#6	8	#6	B	#4	3	2.3	WA-S-102	
	V.2-18	100'-0"						10"	10"	10"	10"	1'-2"	1"	7"	7"		III	2	4	1"	1'-4"	4"									8	#6	B	#4	3			
1	W-17.2	100'-0"	B	2	4'-0"	9'-0"	1'-6"	10"	10"	10"	10"	1'-2"	1"	7"	7"	5'-0"	III	2	4	1"	1'-4"	4"	5	#6	10	#6	5	#6	10	#6	8	#6	B	#4	3	2.3	WA-S-102	
	W-17	100'-0"						10"	10"	10"	10"	1'-2"	1"	7"	7"		III	2	4	1"	1'-4"	4"									8	#6	B	#4	3			
1	T-16.3	100'-0"	B	2	4'-0"	24'-0"	1'-6"	10"	10"	10"	10"	1'-2"	1"	7"	7"	20'-0"	III	2	4	1"	1'-4"	4"	5	#6	25	#6	5	#6	25	#6	8	#6	B	#4	3	6.0	WA-S-102	
	U-16.3	100'-0"						10"	10"	10"	10"	1'-2"	1"	7"	7"		III	2	4	1"	1'-4"	4"									8	#6	B	#4	3			
1	W-15.3	100'-0"	B	2	4'-0"	24'-0"	1'-6"	10"	10"	10"	10"	1'-2"	1"	7"	7"	20'-0"	III	2	4	1"	1'-4"	4"	5	#6	25	#6	5	#6	25	#6	8	#6	B	#4	3	6.0	WA-S-102	
	W-14.3	100'-0"						10"	10"	10"	10"	1'-2"	1"	7"	7"		III	2	4	1"	1'-4"	4"									8	#6	B	#4	3			
1	U-18	100'-0"	B	2	6'-0"	24'-0"	1'-6"	10"	10"	10"	10"	1'-6"	1"	7"	7"	20'-0"	III	2	4	1"	1'-4"	4"	7	#6	25	#6	7	#6	25	#6	8	#6	B	#4	3	9.0	WA-S-102	
	U-17	100'-0"						10"	10"	10"	10"	1'-6"	1"	7"	7"		III	2	4	1"	1'-4"	4"									8	#6	B	#4	3			
1	K.3-17	100'-0"	—	—	—	—	—	10"	10"	10"	10"	2'-6"	1"	7"	7"	—	III	2	4	1"	1'-4"	4"	—	—	—	—	—	—	—	—	8	#6	B	#4	5	20.0	WA-S-102	FOR ADDITIONAL INFORMATION SEE FDN LOCATION PLAN
	J.3-17	100'-0"						10"	10"	10"	10"	2'-6"	1"	7"	7"		III	2	4	1"	1'-4"	4"									8	#6	B	#4	5			
	J.3-16.3	100'-0"						10"	10"	10"	10"	2'-6"	1"	7"	7"		III	2	4	1"	1'-4"	4"									8	#6	B	#4	5			
	J.3-15.3	100'-0"						10"	10"	10"	10"	2'-6"	1"	7"	7"		III	2	4	1"	1'-4"	4"									8	#6	B	#4	5			
1	K.3-12.3	100'-0"	—	—	—	—	—	—	—	—	—	—	1"	7"	7"	—	III	2	4	1"	1'-4"	4"	—	—	—	—	—	—	—	—	—	—	—	—	—	42.0	WA-S-102	FOR ADDITIONAL INFORMATION SEE FDN LOCATION PLAN
	J.3-12.3	100'-0"											1"	7"	7"		III	2	4	1"	1'-4"	4"															
	J.3-11.3	100'-0"											1"	7"	7"		III	2	4	1"	1'-4"	4"															
	J.3-10.3	100'-0"											1"	7"	7"		III	2	4	1"	1'-4"	4"															
	K.3-10.3	100'-0"											1"	7"	7"		III	2	4	1"	1'-4"	4"															
	L.3-10.3	100'-0"											1"	7"	7"		III	2	4	1"	1'-4"	4"															
1	P.3-14.3	100'-0"	—	—	—	—	—	10"	10"	10"	10"	2'-6"	1"	7"	7"	—	III	2	4	1"	1'-4"	4"	—	—	—	—	—	—	—	—	8	#6	B	#4	5	14.3	WA-S-102	FOR ADDITIONAL INFORMATION SEE FDN LOCATION PLAN
	N.3-14.3	100'-0"						10"	10"	10"	10"	2'-6"	1"	7"	7"		III	2	4	1"	1'-4"	4"									8	#6	B	#4	5			
	N.3-13.3	100'-0"						10"	10"	10"	10"	2'-6"	1"	7"	7"		III	2	4	1"	1'-4"	4"									8	#6	B	#4	5			
1	M.3-11.3	100'-0"	—	—	—	—	—	—	—	—	—	—	1"	7"	7"	—	III	2	4	1"	1'-4"	4"	—	—	—	—	—	—	—	—	—	—	—	—	—	15.0	WA-S-102	FOR ADDITIONAL INFORMATION SEE FDN LOCATION PLAN
	M.3-10.3	100'-0"											1"	7"	7"		III	2	4	1"	1'-4"	4"															

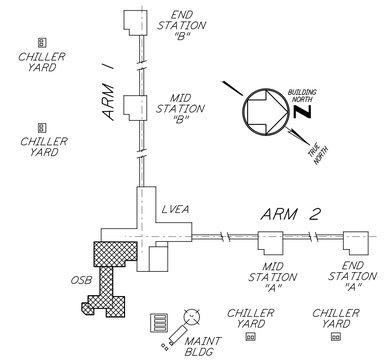

KEY PLAN

LIGO-D960318-01-O

REFERENCES DRAWING NO.	DESCRIPTION

REVISIONS NO.	DATE	BY	CHKD	ENGR	PROJ	DESCRIPTION
1	6-15-98	CKT				ISSUED FOR AS-BUILT

ISSUED FOR CONSTRUCTION		
DRAWN	MCS	6-24-96
CHECKED	DDM	7-2-96
ENGINEER	BP	6-28-96
PROJ	MDW	7-9-96

AS-BUILT DRAWINGS

PARSONS
100 WEST WALNUT STREET
PASADENA, CALIFORNIA

LIGO
CALIFORNIA INSTITUTE OF TECHNOLOGY
MASSACHUSETTS INSTITUTE OF TECHNOLOGY

LASER INTERFEROMETER GRAVITATIONAL-WAVE OBSERVATORY
SITE NO. 1 - HANFORD, WASHINGTON

TITLE	SCALE	CONTRACT NUMBER	PROJECT NUMBER
STRUCTURAL CORNER STATION - OSB FOUNDATION SCHEDULE AND DETAILS SHEET 2	NONE	PP150969	8094
	SHEET NUMBER	WA-S-403	REVISIONS 1

LIGOWAF.BDR

Thu Sep 3 17:38:28 1998 n:\solvt\wf\93-38.wf fs\DUDLEY\E3882\ST403.DWF