

OMIT ALL UNDERGROUND WORK WITHIN CLOUD FROM THIS BID PACKAGE

CONTRACTOR SHALL PROVIDE CABLE AND WIRE FOR ALL UNDERGROUND EXISTING DUCTBANKS.


WIRE AND CABLE FOR CONDUITS IN TECHNICAL FOUNDATION SLAB SHALL BE PROVIDED BY OTHERS

GENERAL NOTES:

1. FOR STANDARD SYMBOLS, ABBREVIATIONS AND ACRONYMS SEE DWG. WA-E-001.
2. FOR ELECTRICAL SYMBOLS SEE DWG. WA-E-002.
3. FOR STANDARD INSTALLATION DETAILS SEE DWG. WA-E-405 THRU WA-E-407.
4. FOR CABLE TYPE DESCRIPTION SEE DWG. WA-E-007.
5. ALL RUNS ARE SHOWN DIAGRAMMATICALLY ONLY. CONTRACTOR SHALL COORDINATE INSTALLATION WITH OTHER DISCIPLINES.
6. COORDINATES OF CDS POWER CONDUIT STUB-UPS SHALL BE COORDINATED WITH THE VACUUM EQUIPMENT VENDOR.

NOTES:

1. FOR NODE NUMBERING SCHEDULE SEE DWG. WA-E-008.

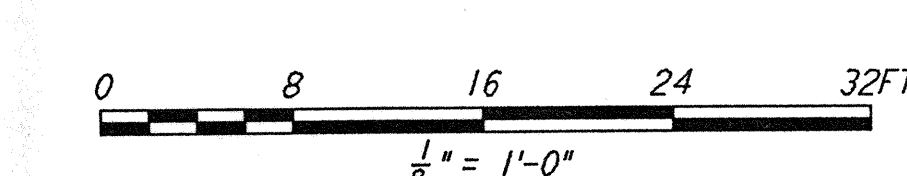

KEY PLAN

NO.	DATE	BY	CHKD	ENGR	PROJ	DESCRIPTION
A	4-19-96	M.M.	Y.L.	R.L.	PTM	FINAL DESIGN REVIEW & BID

DRAWN	M.M.
CHECKED	
ENGINEER	
PROJ	

PARSONS
 100 WEST WALNUT STREET
 PASADENA, CALIFORNIA

LIGO
 CALIFORNIA INSTITUTE OF TECHNOLOGY
 MASSACHUSETTS INSTITUTE OF TECHNOLOGY

LASER INTERFEROMETER
 GRAVITATIONAL-WAVE OBSERVATORY
 SITE NO. 1 - HANFORD, WASHINGTON

TITLE: **ELECTRICAL MID & END B STATIONS UNDERGROUND PLAN**

AS NOTED PP150969 8094

WA-E-213

LIGO-D960419-A-0

not be reproduced, copied, loaned, exhibited, or used in any other way, except by written consent from PARSONS to the borrower.

This document and the design it covers are the property of PARSONS. They are loaned only with the borrower's expressed written agreement that they will

HP: BT 2141207 1796 8370002 -05VLUITS\BUDGET\15062\EE\213.DWG

HP: BT 2141207 1796 8370002 -05VLUITS\BUDGET\15062\EE\213.DWG