


- NOTES:**
- 1.) DATA HIGHWAY EXTENSION CABLES FOR BAKEDOUT CART TO CONNECTION BOX ARE PROVIDED W/CART.
 - 2.) FOR DATA HIGHWAY INTERCONNECTING WIRING SEE DWG. V049-3-131.
 - 3.) IDENTIFY ALL CONNECTION BOXES WITH BLACK PHENOLIC TAGS WITH WHITE LETTERING. LETTERING SHALL BE 3/8" HIGH.
 - 4.) LOCATE CONNECTION BOXES ADJACENT TO BAKEDOUT CART CONTROL POWER. SEE PSI DWG. #V049-3-116

MATCHLINE SEE DWG. V049-3-130

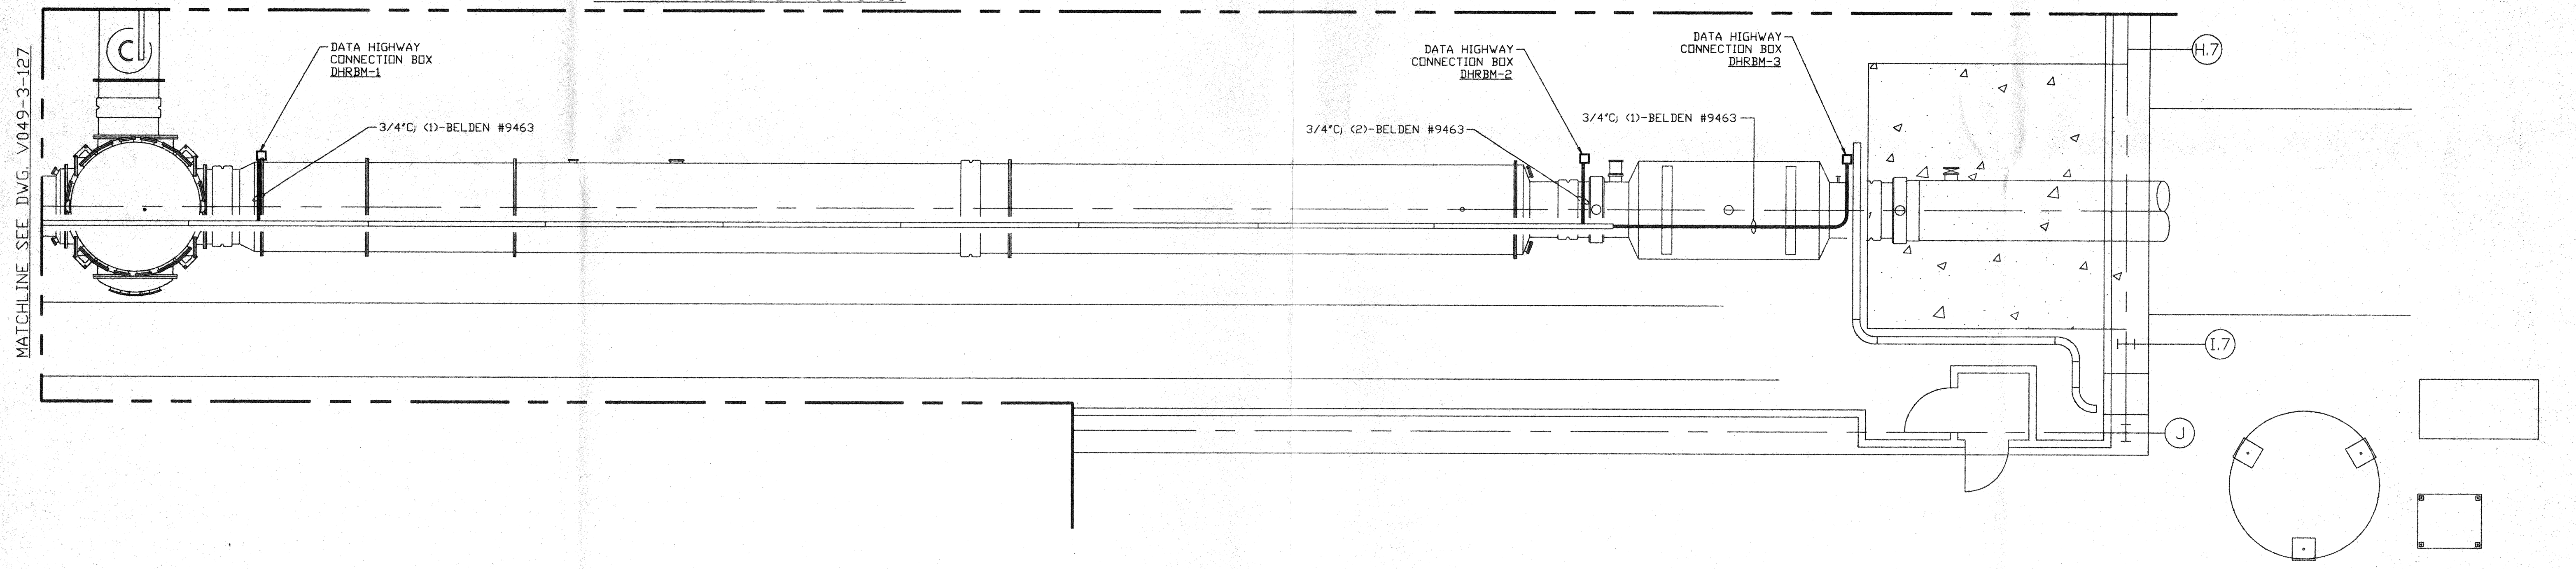

MATCHLINE SEE DWG. V049-3-127

NOTED
CORRECTION

APR 30 1996

D960572-00-V

PROPRIETARY AND CONFIDENTIAL <small>THIS DOCUMENT CONTAINS PROPRIETARY INFORMATION BELONGING TO PROCESS SYSTEMS INTERNATIONAL, INC. OR ITS AFFILIATED COMPANIES AND SHALL BE USED ONLY FOR THE PURPOSE FOR WHICH IT WAS SUPPLIED. IT SHALL NOT BE COPIED, REPRODUCED OR OTHERWISE USED, NOR SHALL SUCH INFORMATION BE FURNISHED IN WHOLE OR IN PART TO OTHERS EXCEPT IN ACCORDANCE WITH THE TERMS OF ANY AGREEMENT UNDER WHICH IT WAS SUPPLIED OR WITH THE PRIOR WRITTEN CONSENT OF PROCESS SYSTEMS INTERNATIONAL, INC. AND SHALL BE RETURNED UPON REQUEST.</small>	V049-3-131	DATA HIGHWAY INTERCONNECTION DIAGRAM			<small>UNLESS OTHERWISE SPECIFIED DIMENSIONS ARE IN INCHES TOLERANCES: FRACTIONAL ± ANGULAR/RADIUS 40°-30° BEND ±2° TWO PLACE DECIMAL ± .01 THREE PLACE DECIMAL ± .005 FINISHED SURFACE RMS BREAK CORNERS IN OUT REMOVE ALL BURRS</small>						PROCESS SYSTEMS INTERNATIONAL, INC. <small>20 WALKUP DR. WESTBOROUGH, MASSACHUSETTS 01581 USA</small> DATA HIGHWAY PLAN LIGO VACUUM EQUIPMENT WASHINGTON SITE RIGHT BEAM MANIFOLD	<small>CAD FILE V0493129</small>	<small>SIZE D</small>	<small>DWG. NO. V049-3-129</small>	<small>REV. 0</small>	
	V049-3-118	POWER PLAN RIGHT BEAM MANIFOLD														
	V049-3-108	CABLE TRAY PLAN RIGHT BEAM MANIFOLD														
	V049-3-002	WASHINGTON OVERALL SITE PLAN														
	V049-3-001	GENERAL NOTES & LEGEND														
	DWG. NO.	DESCRIPTION	DWG. NO.	DESCRIPTION		DO NOT SCALE THIS DRAWING	0	ISSUE FOR FDR								
	REFERENCE DRAWINGS					USED ON:	REV	DESCRIPTION	CHKD	DRWN	DATE	DEC#	SCALE	3/16" = 1' - 0"	SHEET	1 OF 1