DATE: 01/21/99 TIME: 13:48:22
DESIGN FILE: I:\ligo\site1\ce\btc026.dgz

This document and the design it covers are the property of **PARSONS**. They are loaned only with the borrower's expressed written agreement that they will not be reproduced, copied, loaned, exhibited, or used in any other way, except by written consent from **PARSONS** to the borrower.

NOTES:

1. SEE SHEET BT-C-002 FOR GENERAL NOTES, LEGEND AND ABBREVIATIONS.

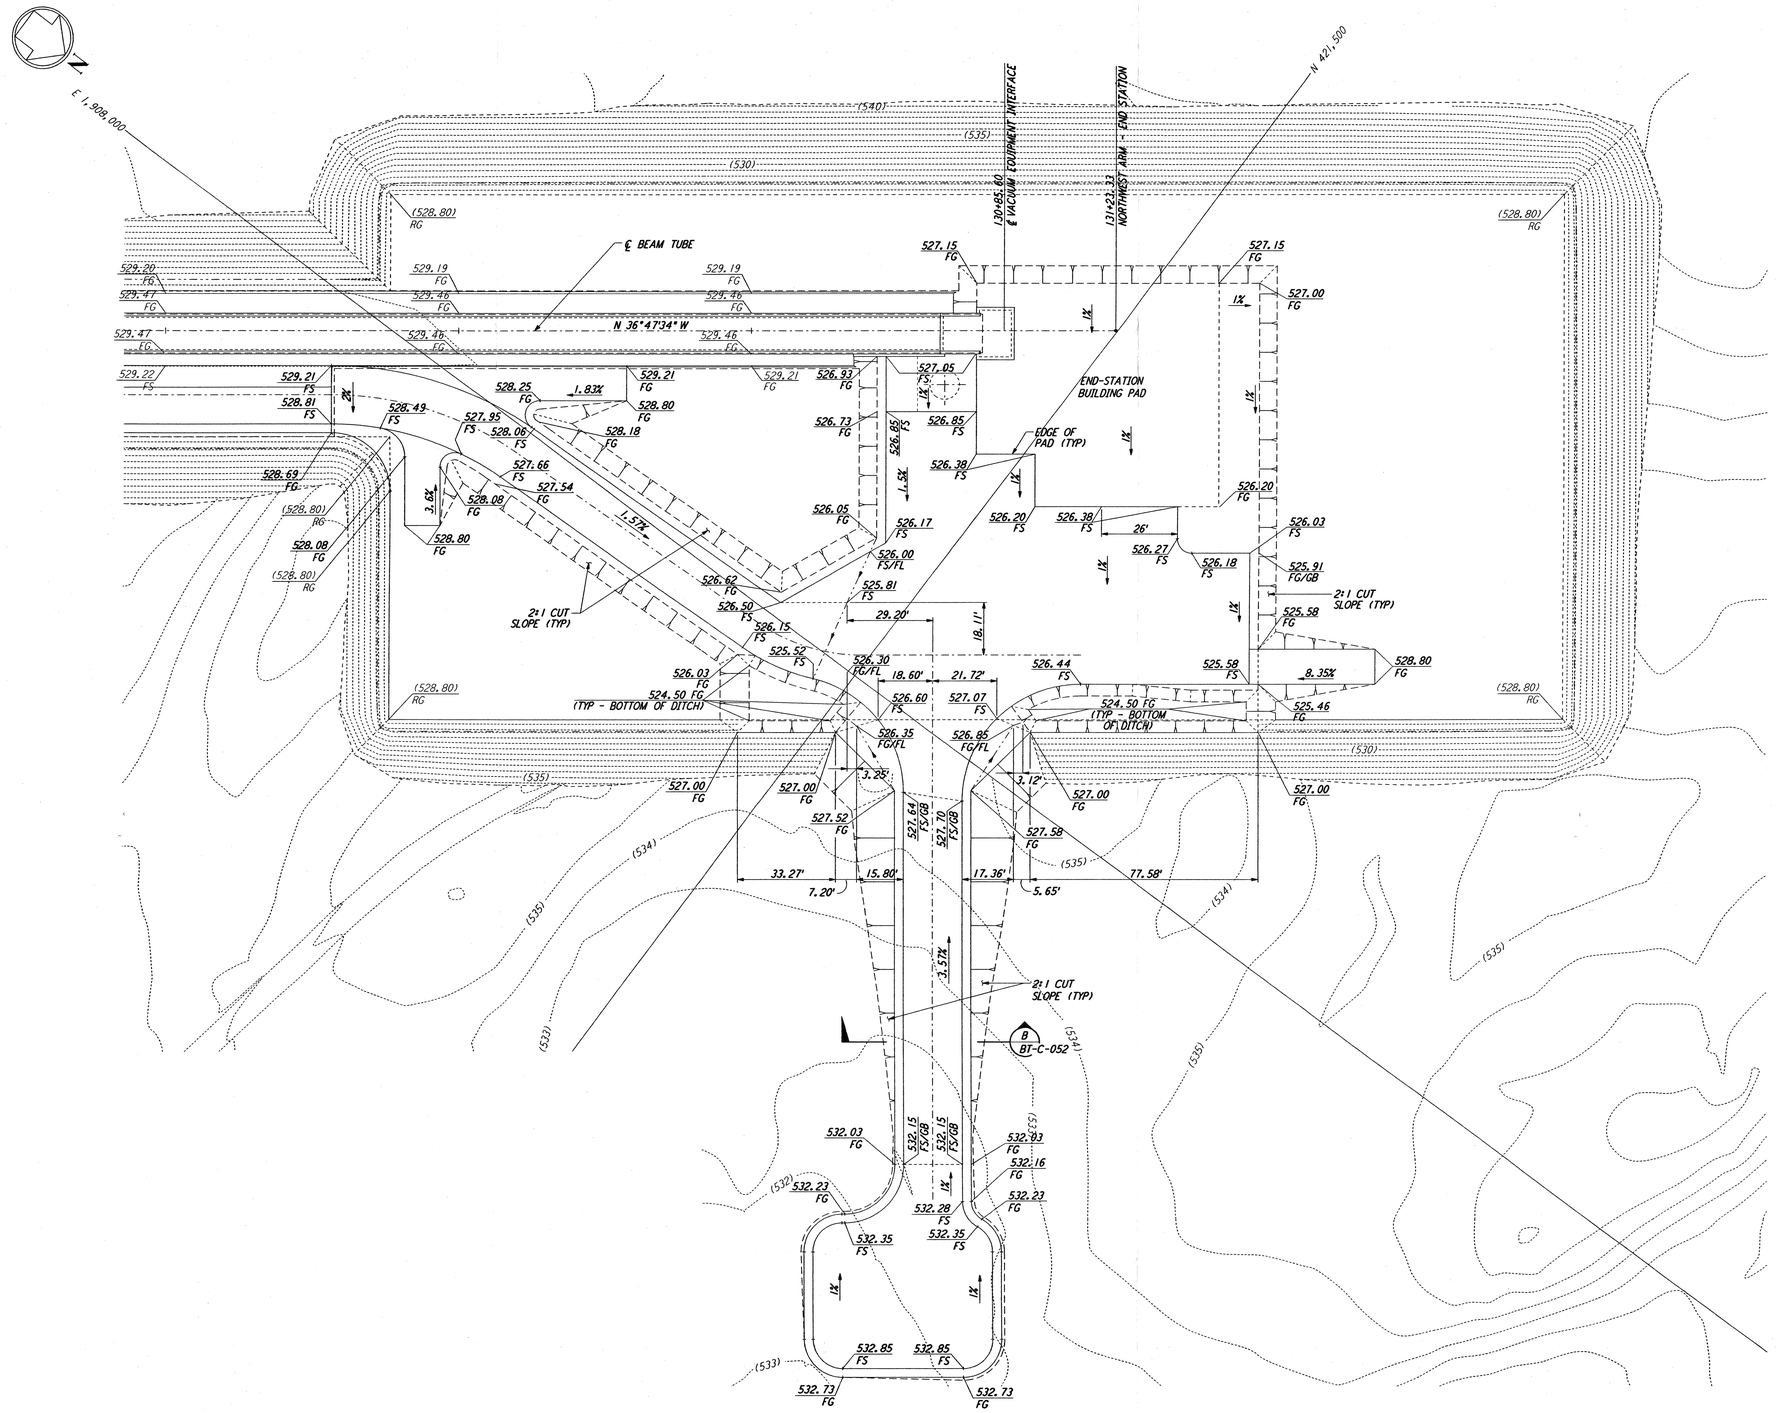

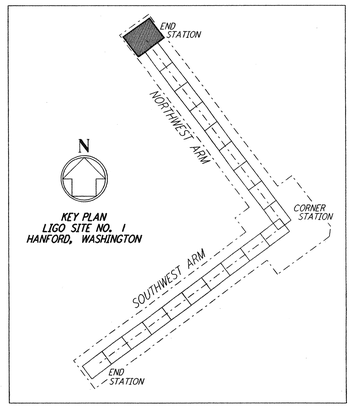

LIGO-D960720-00-O

GRAPHIC SCALE
0 20 40 60 80
SCALE: 1" = 20'

REFERENCES			REVISIONS						
DRAWING NO.	DESCRIPTION		NO.	DATE	BY	CHKD	ENGR	PROJ	DESCRIPTION
			0	1-22-99	MEI	--	--	MDW	ISSUED FOR AS BUILT
			A	4-19-96	WRB	TDM		MDW	CHANGE ORDER NO. 4

DRAWN	WRB	
CHECKED		
ENGINEER		
PROJ		

AS-BUILT DRAWINGS

PARSONS
100 WEST WALNUT STREET
PASADENA, CALIFORNIA

LIGO
CALIFORNIA INSTITUTE OF TECHNOLOGY
MASSACHUSETTS INSTITUTE OF TECHNOLOGY

LASER INTERFEROMETER GRAVITATIONAL-WAVE OBSERVATORY
BTE SITEWORK & FABRICATION - HANFORD, WA

TITLE	SCALE	CONTRACT NUMBER	PROJECT NUMBER
CIVIL NORTHWEST ARM END-STATION GRADING PLAN	1" = 20'	PP150969	8094
	SHEET NUMBER		REVISIONS
	BT-C-026		0

LIGOBTF3.BDR

Thu Jan 21 13:47:18 1999 C:\PLOT\DWE53-V3682.DCF 52865 K1V3682\ce826a.prf