DATE: 10/06/98 TIME: 13:49:53
DESIGN FILE: I:\ligo\site2\ce\lac027.dgz

NOTES:

1. SEE SHEET LA-C-002 FOR GENERAL NOTES, LEGEND AND ABBREVIATIONS.

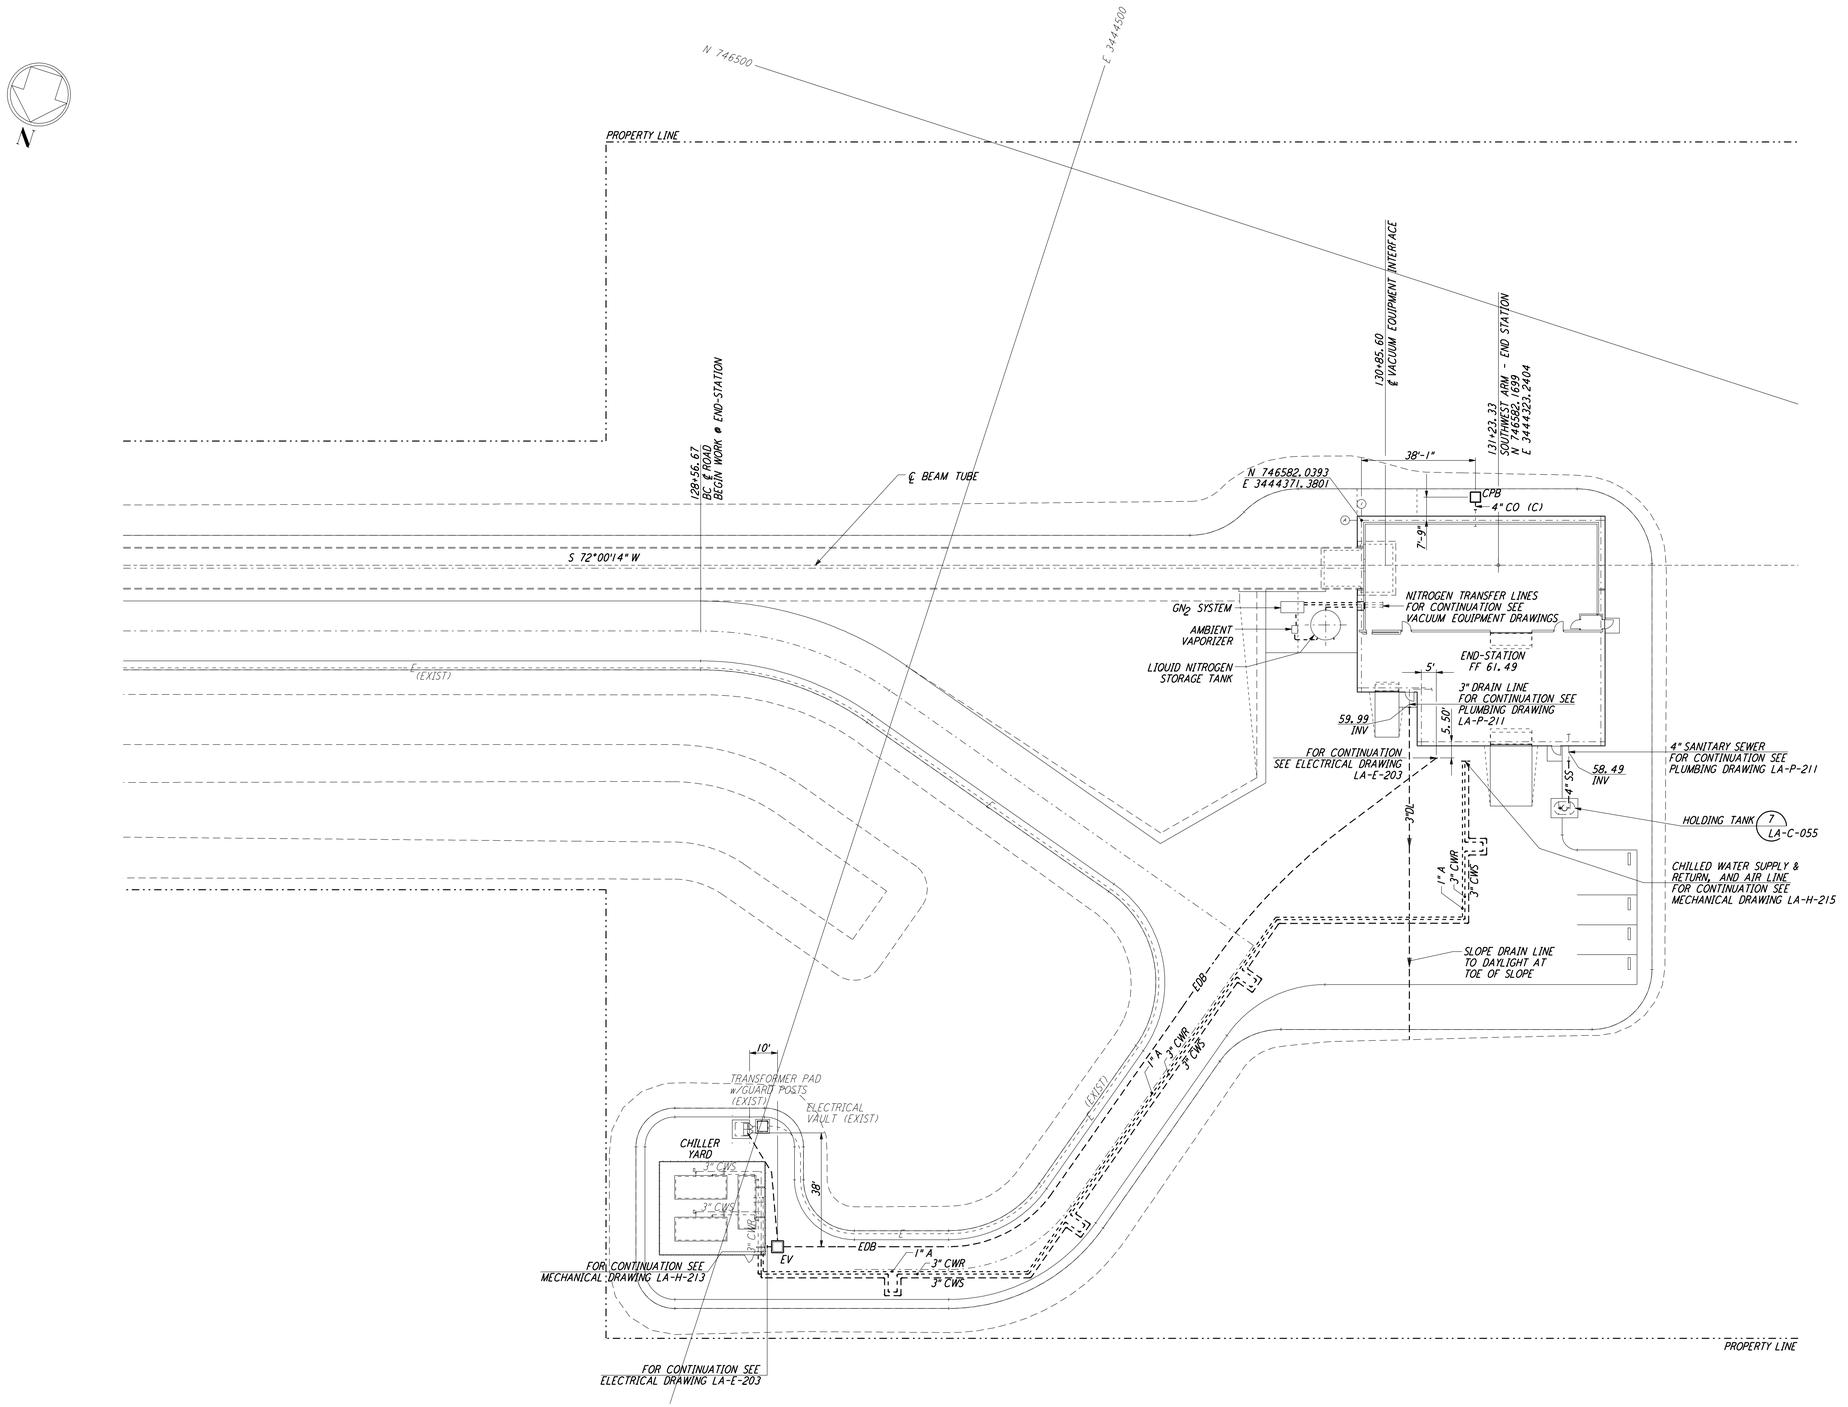

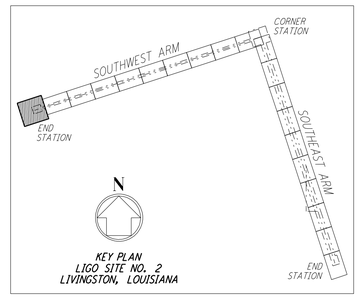

KEY PLAN
LIGO SITE NO. 2
LIVINGSTON, LOUISIANA

GRAPHIC SCALES
0 20 40 60 80
SCALE: 1" = 20'

LIGO-D960844-01-O

This document and the design it covers are the property of PARSONS. They are loaned only with the borrower's expressed written agreement that they will not be reproduced, copied, loaned, exhibited, or used in any other way, except by written consent from PARSONS to the borrower.

REFERENCES	
DRAWING NO.	DESCRIPTION

REVISIONS						
NO.	DATE	BY	CHKD	ENGR	PROJ	DESCRIPTION
1	08-07-98	WRB				ISSUED FOR AS-BUILT

0 ISSUED FOR CONSTRUCTION		
DRAWN	WRB	11-15-96
CHECKED	ML	11-15-96
ENGINEER	JB	11-15-96
PROJ	TDM	11-15-96

AS-BUILT DRAWINGS

PARSONS
100 WEST WALNUT STREET
PASADENA, CALIFORNIA

LIGO
CALIFORNIA INSTITUTE OF TECHNOLOGY
MASSACHUSETTS INSTITUTE OF TECHNOLOGY

LASER INTERFEROMETER
GRAVITATIONAL-WAVE OBSERVATORY
SITE NO. 2 - LIVINGSTON, LOUISIANA

TITLE: CIVIL SOUTHWEST ARM END-STATION UTILITY PLAN

SCALE	CONTRACT NUMBER	PROJECT NUMBER
1" = 20'	PP150969	8094

SHEET NUMBER: LA-C-027 REVISIONS: 1

LIGOLAF3.BDR

Tue Oct 6 13:49:19 1998 c:\plot\qcf\S3-30.qcf N:\QUEUES\E3082\CE027.PRF