DATE: 10/07/98 TIME: 09:05:22
DESIGN FILE: I:\ligo\site2\ar\laa111.d3z

NOTE: SEE SPECIFICATIONS FOR ADDITIONAL INFORMATION AND SCHEDULES

This document and the design it covers are the property of **PARSONS**. They are loaned only with the borrower's expressed written agreement that they will not be reproduced, copied, loaned, exhibited, or used in any other way, except by written consent from **PARSONS** to the borrower.

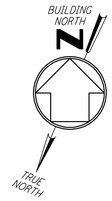

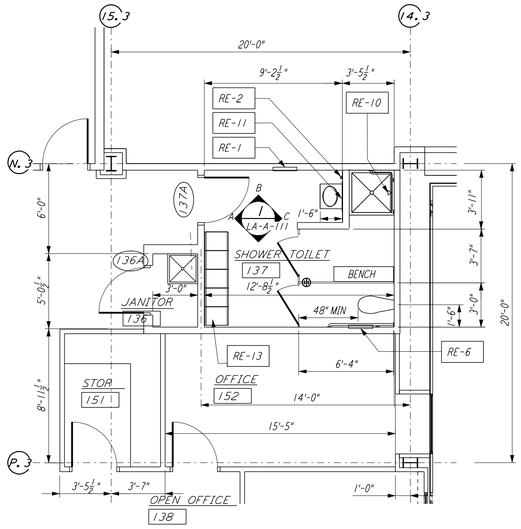

ENLARGED PLAN

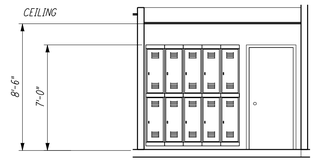

ELEVATION A

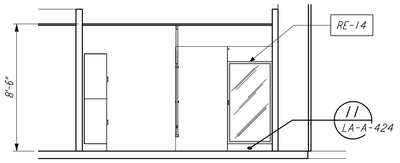

ELEVATION B

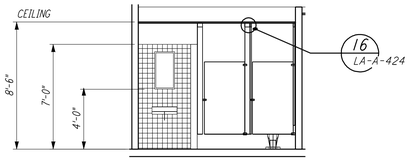

ELEVATION C

JANITOR 136 / SHOWER TOILET 137

1/4" = 1'-0"

1 LA-A-111 REF LA-A-108

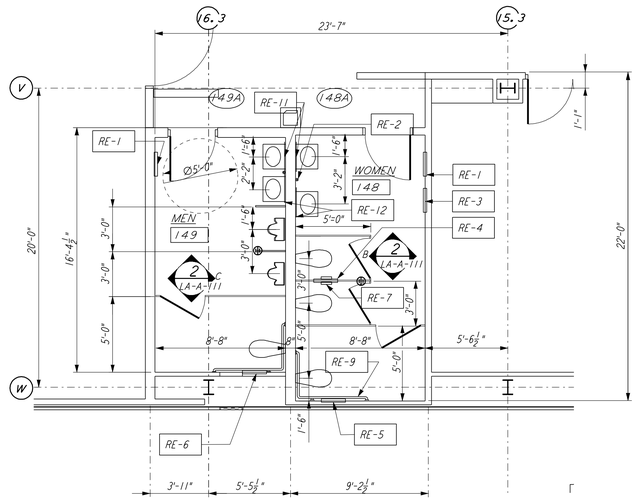

ENLARGED TOILET PLAN

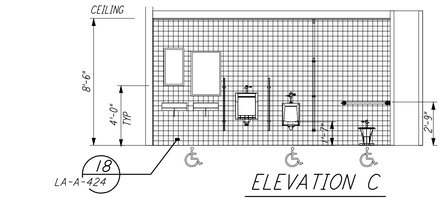

ELEVATION C

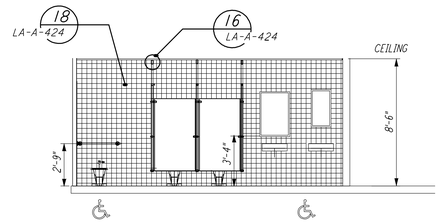

ELEVATION B

MEN 149 / WOMEN 148

1/4" = 1'-0"

2 LA-A-111 REF LA-A-108

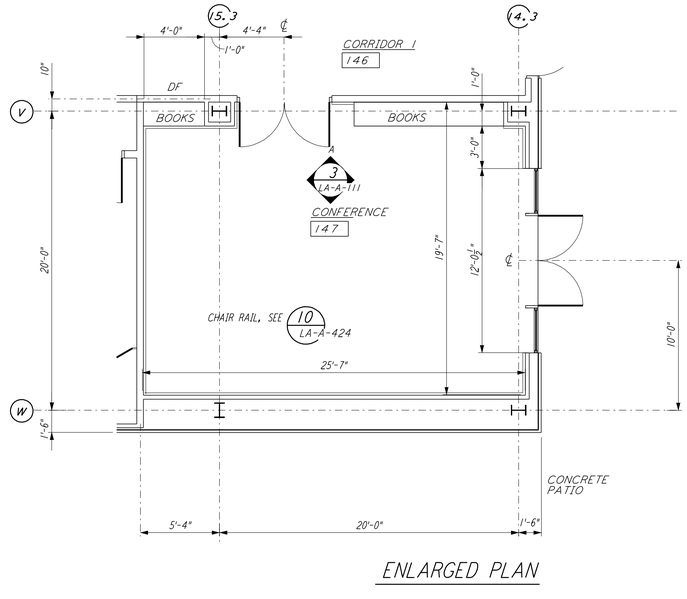

ENLARGED PLAN

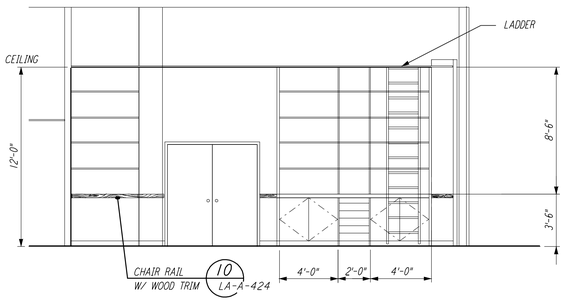

ELEVATION A

CONFERENCE ROOM 147

1/4" = 1'-0"

3 LA-A-111 REF LA-A-108

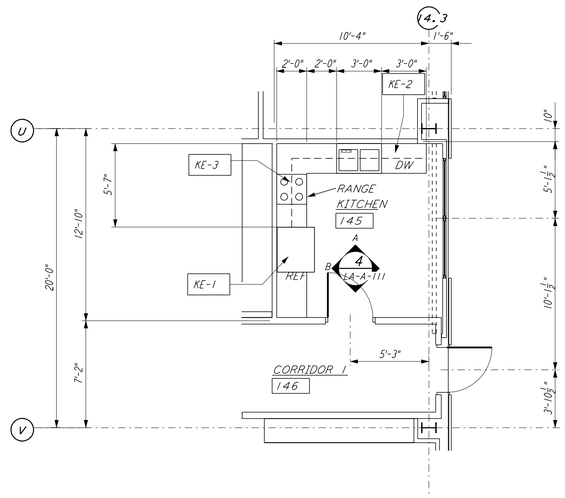

ENLARGED KITCHEN PLAN

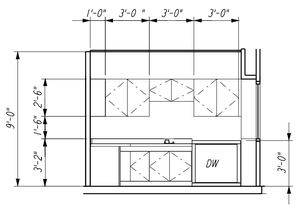

ELEVATION A

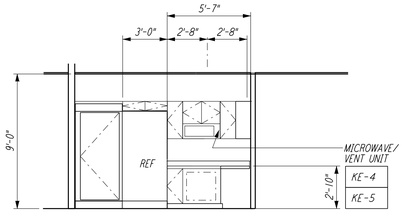

ELEVATION B

KITCHEN PLAN 145

1/4" = 1'-0"

4 LA-A-111 REF LA-A-108

0 4 8 12 16FT
1/4" = 1'-0"

LIGO-D960876-02-O

REFERENCES		REVISIONS							
DRAWING NO.	DESCRIPTION	NO.	DATE	BY	CHKD	ENGR	PROJ	DESCRIPTION	
		2	08-07-98	SJM				ISSUED FOR AS-BUILT	
		1	2-28-97	CKT	TB	AK	TDM	OSB REVISION	

ISSUED FOR CONTRUCTION		
DRAWN	CKT	11-15-96
CHECKED	TB	11-15-96
ENGINEER	SF	11-15-96
PROJ	MDW	11-15-96

AS-BUILT DRAWINGS

PARSONS
100 WEST WALNUT STREET
PASADENA, CALIFORNIA

LIGO
CALIFORNIA INSTITUTE OF TECHNOLOGY
MASSACHUSETTS INSTITUTE OF TECHNOLOGY

LASER INTERFEROMETER GRAVITATIONAL-WAVE OBSERVATORY
SITE NO.2 - LIVINGSTON, LOUISIANA

TITLE: ARCHITECTURAL CORNER STATION OSB ENLARGED PLANS

SCALE: AS NOTED | CONTRACT NUMBER: PP150969 | PROJECT NUMBER: 8094

SHEET NUMBER: LA-A-111 | REVISIONS: 2

LIGOLAF3.BDR

Wed Oct 7 09:04:38 1998 c:\plot\opf\S3-30.mcf N:\DWEWES\E3082\ARIIIC.PRF