not be reproduced, copied, loaned, exhibited, or used in any other way, except by written consent from PARSONS to the borrower.

This document and the design it covers are the property of PARSONS. They are loaned only with the borrower's expressed written agreement that they will

DATE: 08/19/98 TIME: 12:55:07
DESIGN FILE: I:\ligo\site2\ar\laa423.dgz

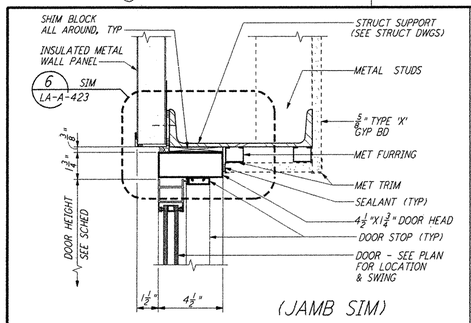

ALUM DOOR HEAD — 16 REF LA-A-423 LA-A-426
3"=1'-0"

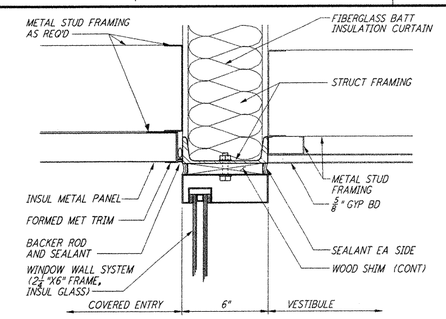

WINDOW WALL HEAD — 12 REF LA-A-423 LA-A-163
3" =1'-0"

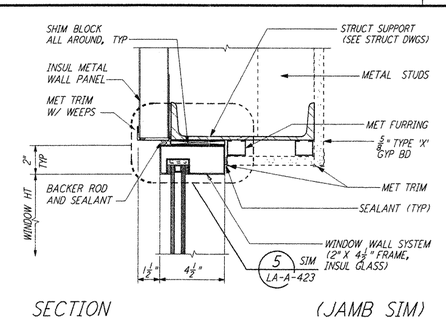

SECTION (JAMB SIM)
ALUMINUM WINDOW HEAD — 8 REF LA-A-423
3" = 1'-0"

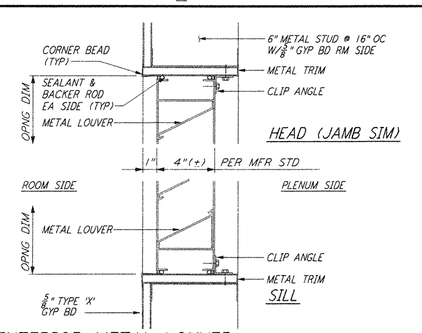

INTERIOR METAL LOUVER — 4 REF LA-A-423 LA-A-162 LA-A-151
3"=1'-0"

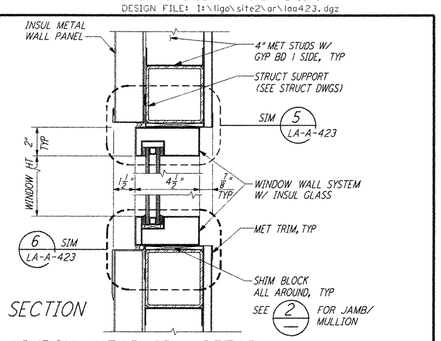

WINDOW HEAD/SILL DETAIL — 1 REF LA-A-423 LA-A-162
3"=1'-0"

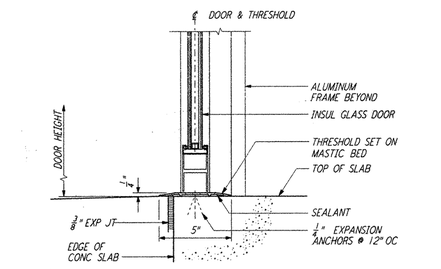

ALUM DOOR/WINDOW JAMB — 17 REF LA-A-423 SEE SPEC
3"=1'-0"

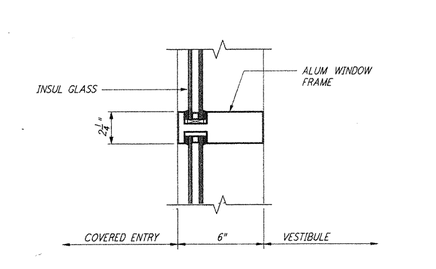

WINDOW WALL DOOR JAMB — 13 REF LA-A-423 SEE SPEC
3"=1'-0"

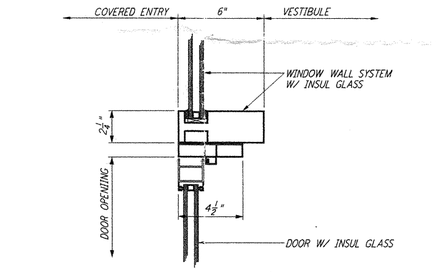

WINDOW WALL MULLION & METAL WALL PANEL — 9 REF LA-A-423 LA-A-108
3" =1'-0"

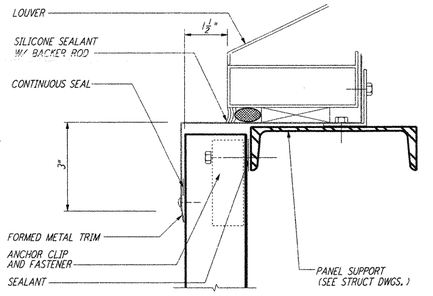

LOUVER HEAD DETAIL — 5 REF LA-A-423 LA-A-142
HALF SIZE

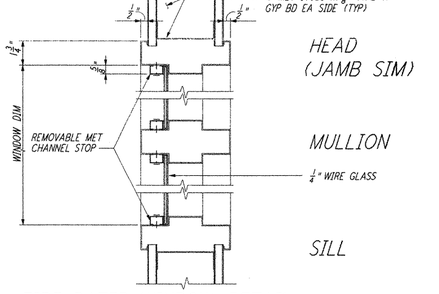

WINDOW JAMB/MULLION DET — 2 REF LA-A-423 LA-A-423
3"=1'-0"

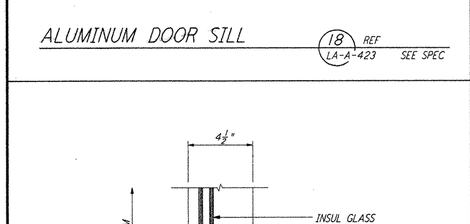

ALUMINUM DOOR SILL — 18 REF LA-A-423 SEE SPEC
3"=1'-0"

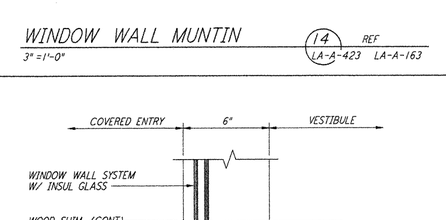

WINDOW WALL MUNTIN — 14 REF LA-A-423 LA-A-163
3" =1'-0"

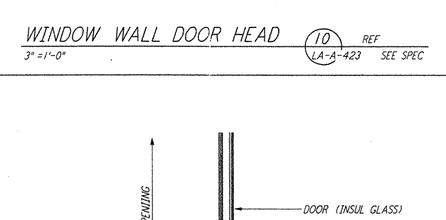

WINDOW WALL DOOR HEAD — 10 REF LA-A-423 SEE SPEC
3" =1'-0"

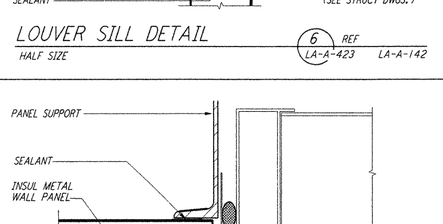

LOUVER SILL DETAIL — 6 REF LA-A-423 LA-A-142
HALF SIZE

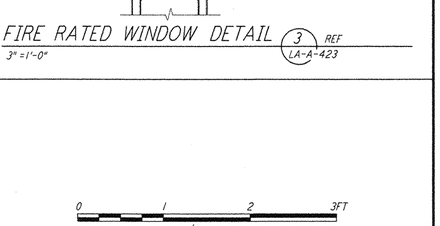

FIRE RATED WINDOW DETAIL — 3 REF LA-A-423
3" =1'-0"

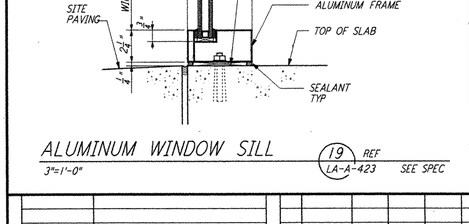

ALUMINUM WINDOW SILL — 19 REF LA-A-423 SEE SPEC
3"=1'-0"

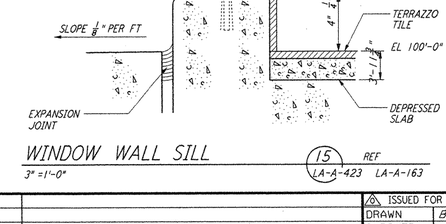

WINDOW WALL SILL — 15 REF LA-A-423 LA-A-163
3" =1'-0"

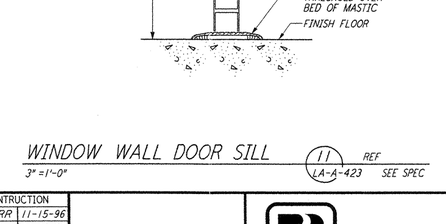

WINDOW WALL DOOR SILL — 11 REF LA-A-423 SEE SPEC
3" =1'-0"

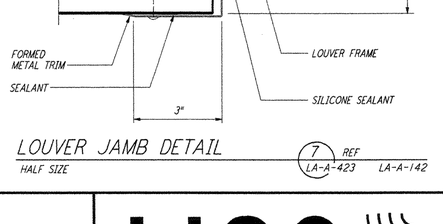

LOUVER JAMB DETAIL — 7 REF LA-A-423 LA-A-142
HALF SIZE

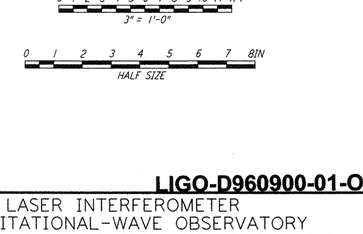

LIGO-D960900-01-O

REFERENCES		REVISIONS							
DRAWING NO.	DESCRIPTION	NO.	DATE	BY	CHKD	ENGR	PROJ	DESCRIPTION
		1	08-07-98	SJM	CKT	LAK	MM	ISSUED FOR AS-BUILT

ISSUED FOR CONTRUCTION		
DRAWN	BK/RR	11-15-96
CHECKED	TB	11-15-96
ENGINEER	SF	11-15-96
PROJ	TDM	11-15-96

AS-BUILT DRAWINGS

PARSONS
100 WEST WALNUT STREET
PASADENA, CALIFORNIA

LIGO
CALIFORNIA INSTITUTE OF TECHNOLOGY
MASSACHUSETTS INSTITUTE OF TECHNOLOGY

LASER INTERFEROMETER GRAVITATIONAL-WAVE OBSERVATORY
SITE NO.2 - LIVINGSTON, LOUISIANA

TITLE: ARCHITECTURAL WINDOW & LOUVER DETAILS

SCALE	CONTRACT NUMBER	PROJECT NUMBER
AS NOTED	PP150969	8094

SHEET NUMBER: LA-A-423 REVISIONS: 1

LIGOLAF.BDR

Wed Aug 19 12:54:26 1998 C:\PLOT\DJE\S3-V3682.DCF 520805 K:\V3682\ar\laa423.prF