This document and the design it covers are the property of PARSONS. They are loaned only with the borrower's expressed written agreement that they will not be reproduced, copied, loaned, exhibited, or used in any other way, except by written consent from PARSONS to the borrower.

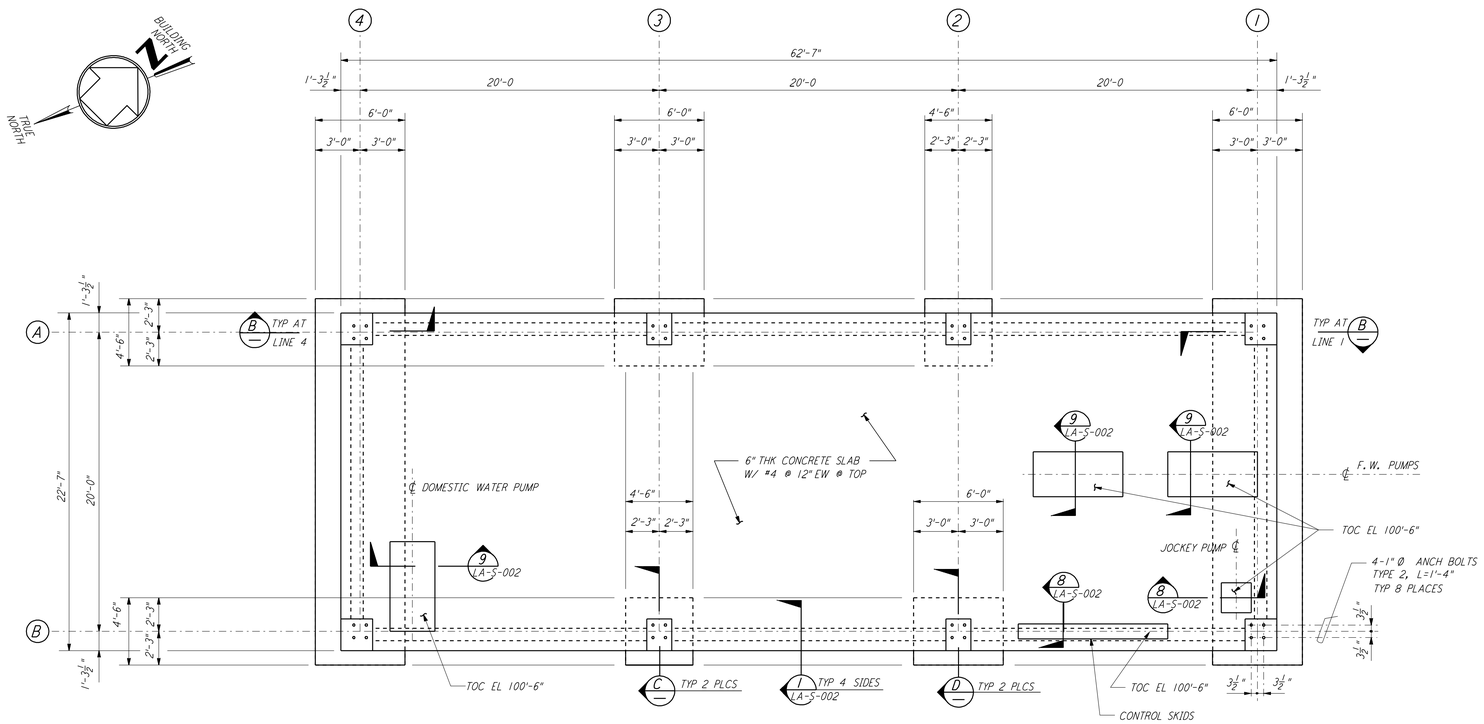

FOR FLOOR SLOPES AND FLOOR DRAINS SEE ARCHITECTURAL DWGS

DATUM POINT EL 100'-0" = EL 63.12'

FOUNDATION PLAN

1/4"=1'-0"

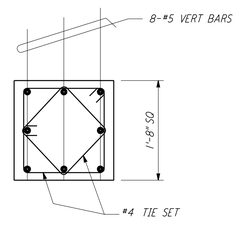

SECTION A
1"=1'-0"

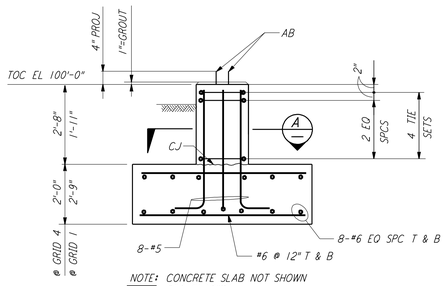

NOTE: CONCRETE SLAB NOT SHOWN FOR CLARITY

SECTION B
1/2"=1'-0"

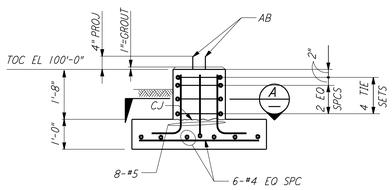

NOTE: CONCRETE SLAB NOT SHOWN FOR CLARITY

SECTION C
1/2"=1'-0"

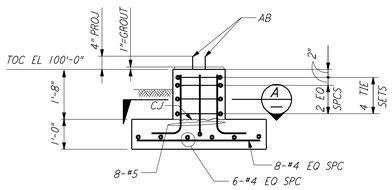

NOTE: CONCRETE SLAB NOT SHOWN FOR CLARITY

SECTION D
1/2"=1'-0"

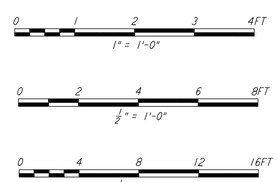

NOTES:

1. FOR STRUCTURAL GENERAL NOTES, ABBREVIATIONS AND LEGEND SEE DWG. LA-S-001.
2. CONTRACTOR TO ADJUST LOCATION AND SIZE OF EQUIPMENT PADS TO SUIT VENDOR EQUIPMENT.
3. ALL VERTICAL SURFACES OF FOUNDATION SHALL BE FORMED.

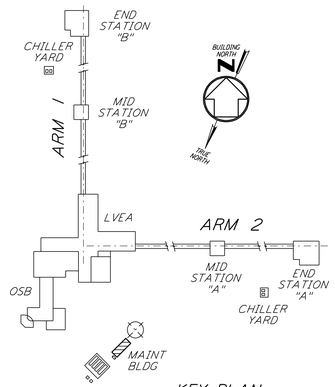

KEY PLAN

LIGO-D960940-01-O

REFERENCES			REVISIONS						
DRAWING NO.	DESCRIPTION		NO.	DATE	BY	CHKD	ENGR	PROJ	DESCRIPTION
			1	08-07-98	WA				ISSUED FOR AS-BUILT

ISSUED FOR CONSTRUCTION		
DRAWN	PK	11-15-96
CHECKED	DDM	11-15-96
ENGINEER	BP	11-15-96
PROJ	TDM	11-15-96

AS-BUILT DRAWINGS

PARSONS
100 WEST WALNUT STREET
PASADENA, CALIFORNIA

LIGO
CALIFORNIA INSTITUTE OF TECHNOLOGY
MASSACHUSETTS INSTITUTE OF TECHNOLOGY

LASER INTERFEROMETER GRAVITATIONAL-WAVE OBSERVATORY
SITE NO.2 - LIVINGSTON, LOUISIANA

TITLE: STRUCTURAL MAINTENANCE BUILDING FDN PLAN & SECTIONS

SCALE	CONTRACT NUMBER	PROJECT NUMBER
AS NOTED	PP150969	8094

SHEET NUMBER: LA-S-124 REVISIONS: 1

LIGOLAF.BDR

Plotted Oct 7 16:03:26 1998 c:\plot\ref\S3-3R.ref N:\DUEUES\E388c\ST124.PRF