



- NOTES:**
- FOR LEGEND, ABBREVIATIONS AND GENERAL NOTES SEE SHEETS LA-H-001 AND LA-H-002.
 - SEE INPUT/OUTPUT SUMMARY SHEETS, SHEETS LA-H-141 AND LA-H-142 FOR ALARMS AND EQUIPMENT CONTROL.

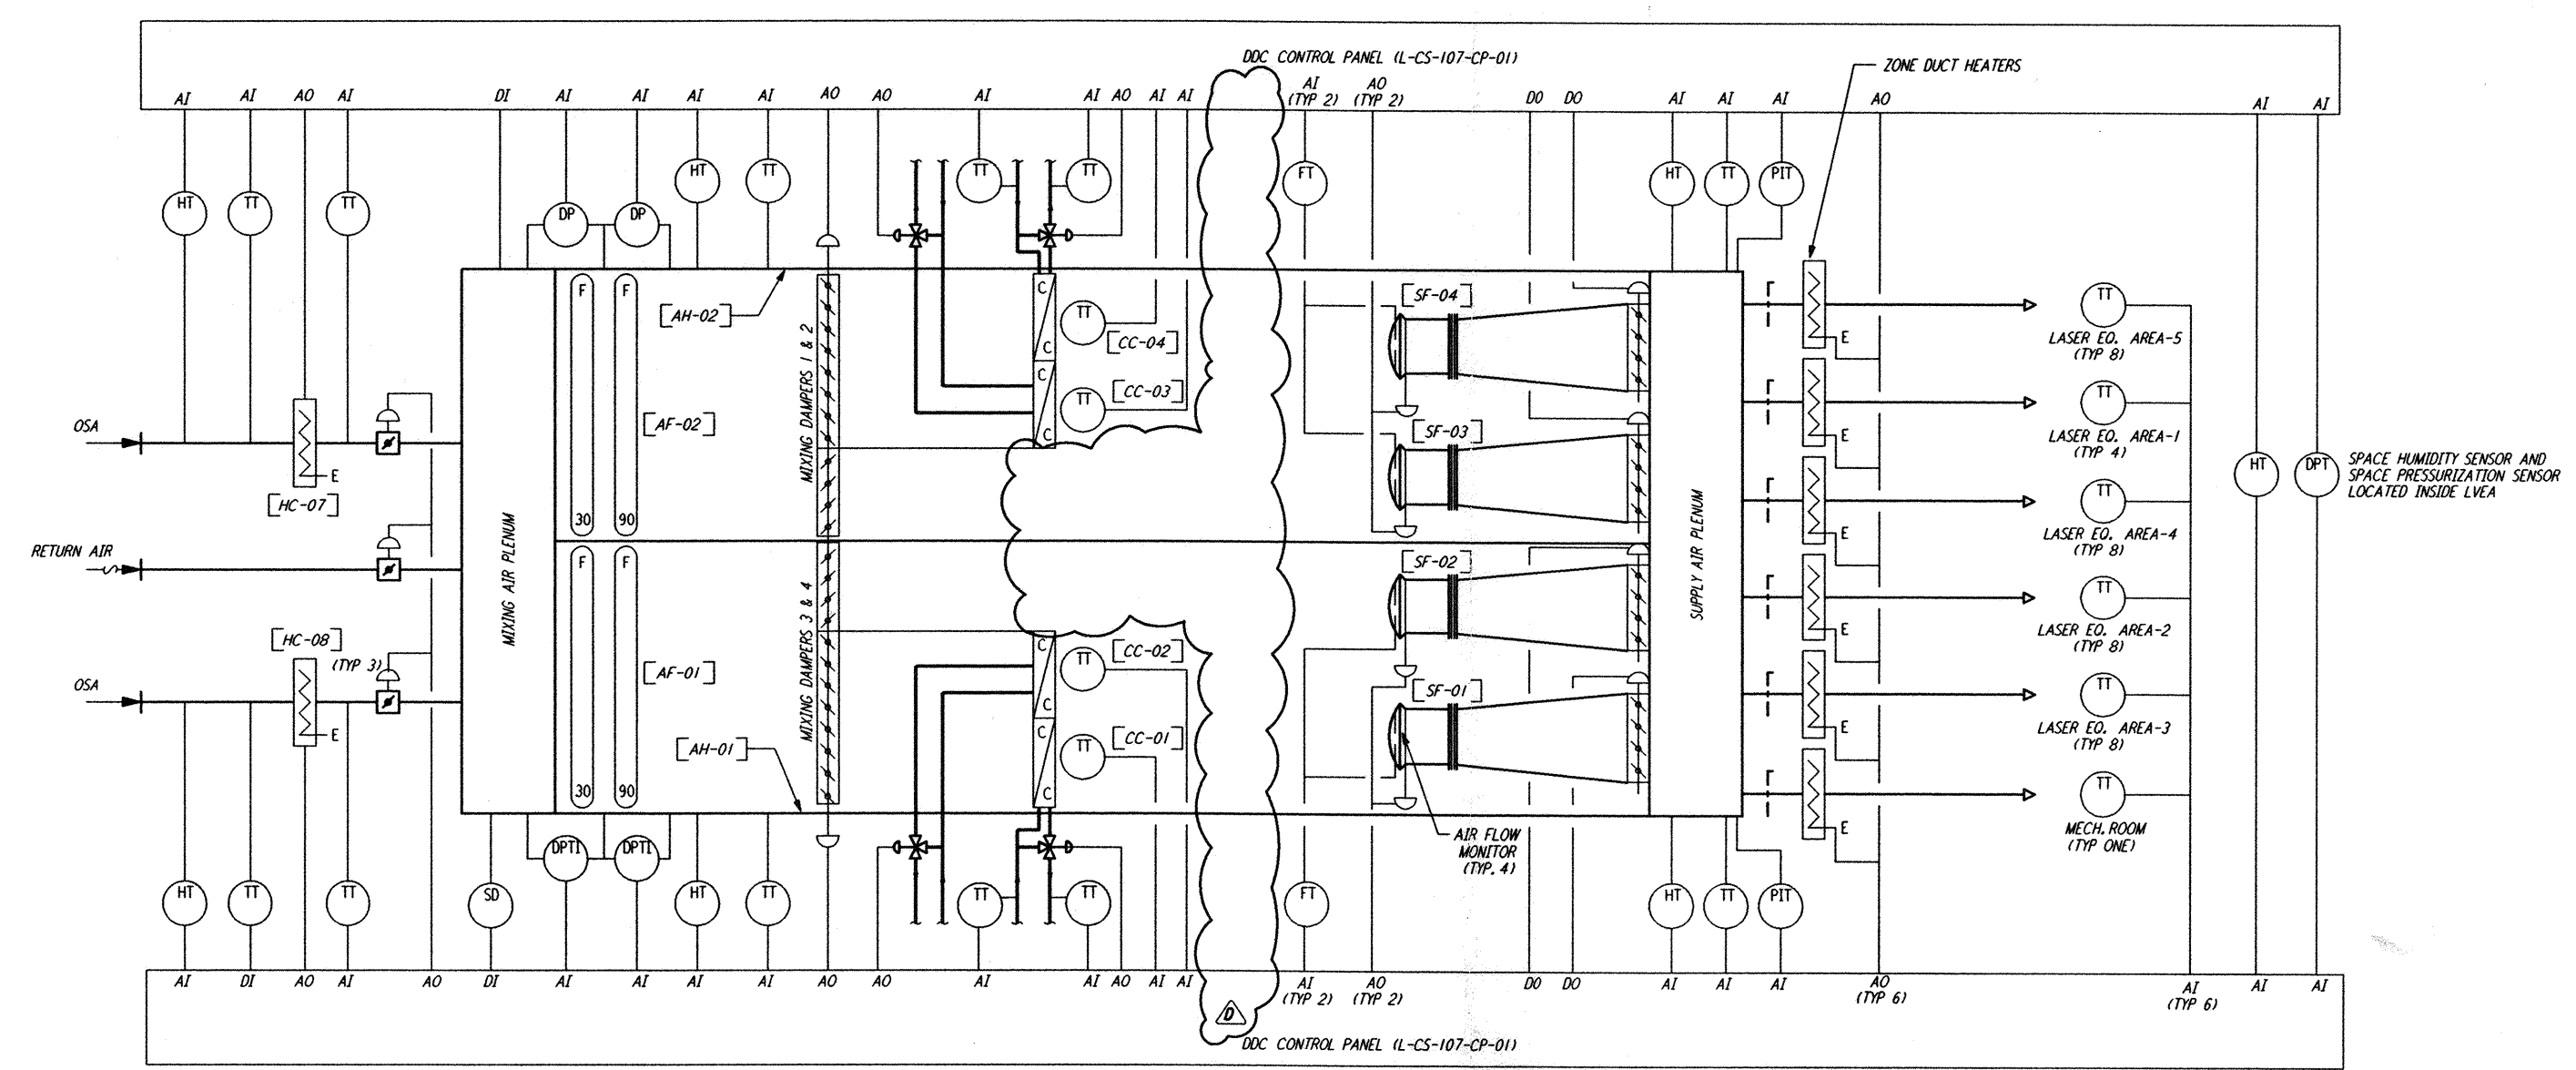

LVEA AIR FLOW & CONTROL DIAGRAM (AH-01 & AH-02)

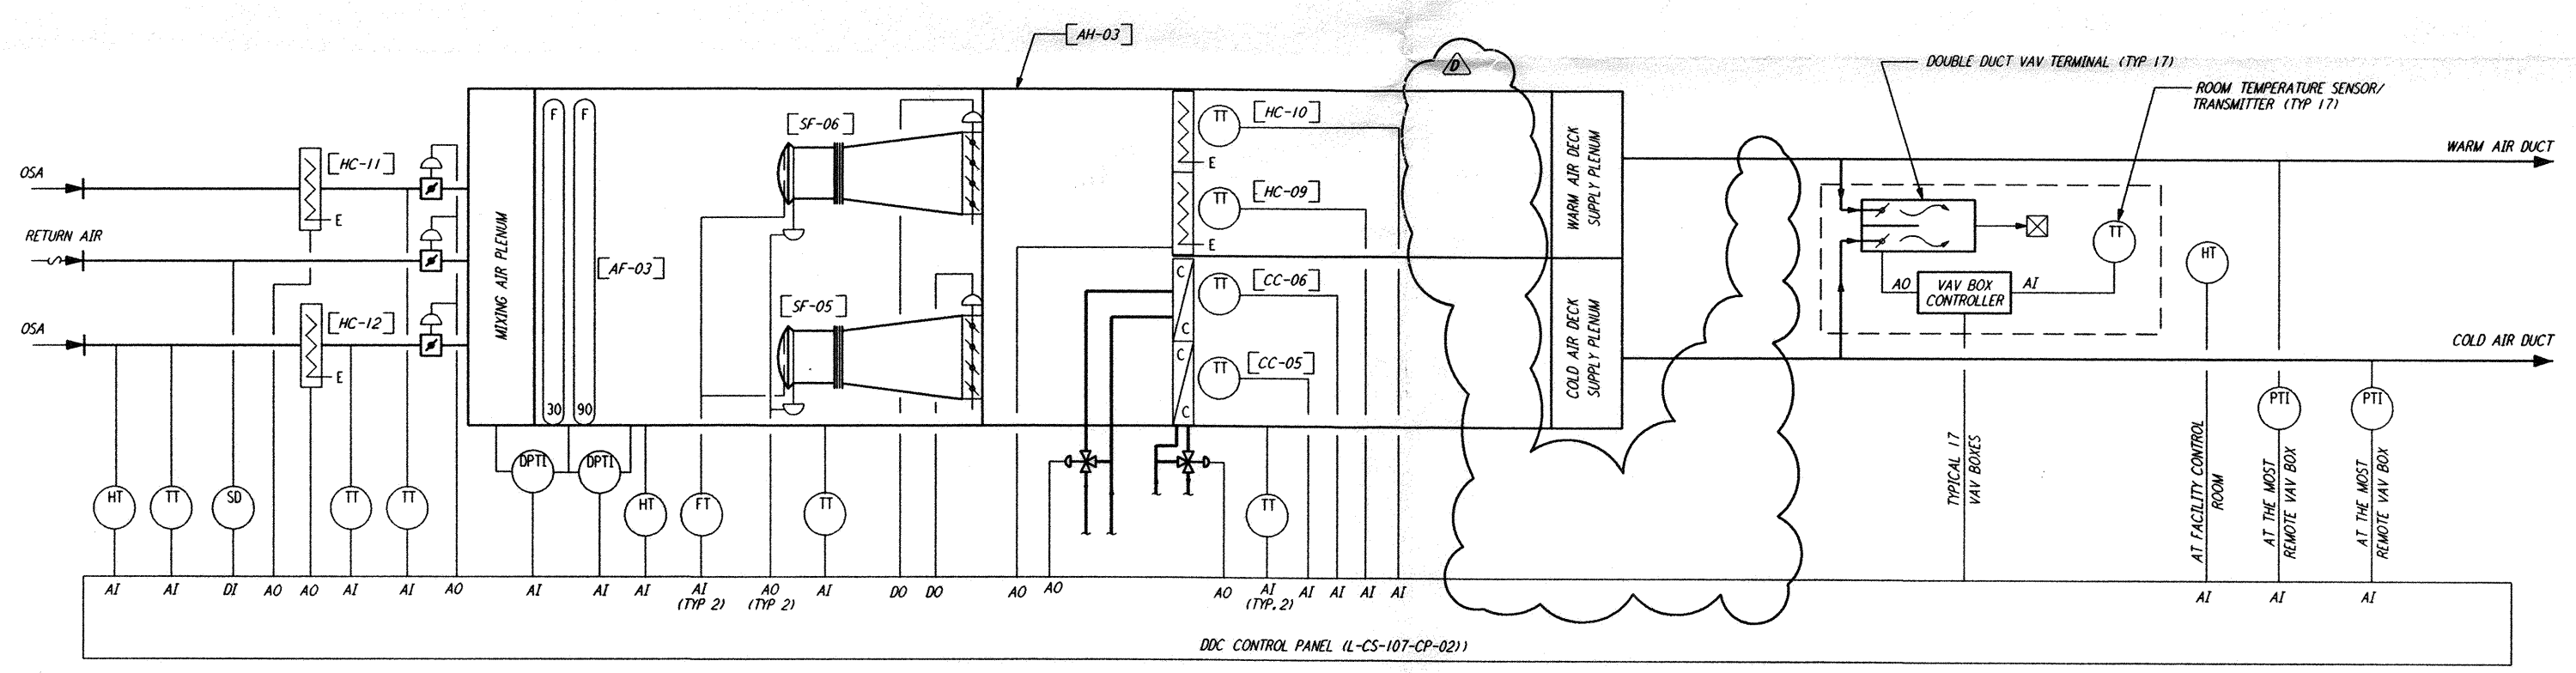

OSB AIR FLOW & CONTROL DAIGRAM (AH-03)

Tue Sep 10 07:20:29 1996 s3-v18b2 J:\PLOTS\QUEUES\18B2\MU122.PRF

not be reproduced, copied, loaned, exhibited, or used in any other way, except by written consent from PARSONS to the borrower.

This document and the design it covers are the property of PARSONS. They are loaned only with the borrower's expressed written agreement that they will

NO.	DATE	BY	CHK'D	ENGR	PROJ	DESCRIPTION
D	9-10-96	CLP	ME	AA	TDM	BID ADDENDUM #2
C	7-24-96	CLP	ME	AA	TDM	ISSUED FOR BID
B	6-14-96	CLP	ME	AA	TDM	FINAL DESIGN REVIEW
A	10-31-95	CLP	ME	AA	TDM	PRELIMINARY DESIGN REVIEW

DRAWN	CLP
CHECKED	
ENGINEER	
PROJ	

PARSONS
 100 WEST WALNUT STREET
 PASADENA, CALIFORNIA

LIGO
 CALIFORNIA INSTITUTE OF TECHNOLOGY
 MASSACHUSETTS INSTITUTE OF TECHNOLOGY

LASER INTERFEROMETER
 GRAVITATIONAL-WAVE OBSERVATORY
 SITE NO. 2 - LIVINGSTON, LOUISIANA

TITLE	SCALE	CONTRACT NUMBER	PROJECT NUMBER
HVAC CORNER STATION AIR FLOW DIAGRAMS SHEET 1	NONE	PPI 50969	8094

LA-H-122