



Tue Sep 10 07:27:57 1996 s3-v18b2 J:\PLOTS\QUEUES\18B2\MU221.PRF

- NOTES:**
- FOR LEGEND, ABBREVIATIONS AND GENERAL NOTES SEE SHEETS LA-H-001 AND LA-H-002.
 - FOR PIPING DETAILS OF COOLING COILS, WATER CHILLERS, PUMPS AND CHEMICAL POT FEEDERS SEE SHEETS LA-H-411 AND LA-H-412.

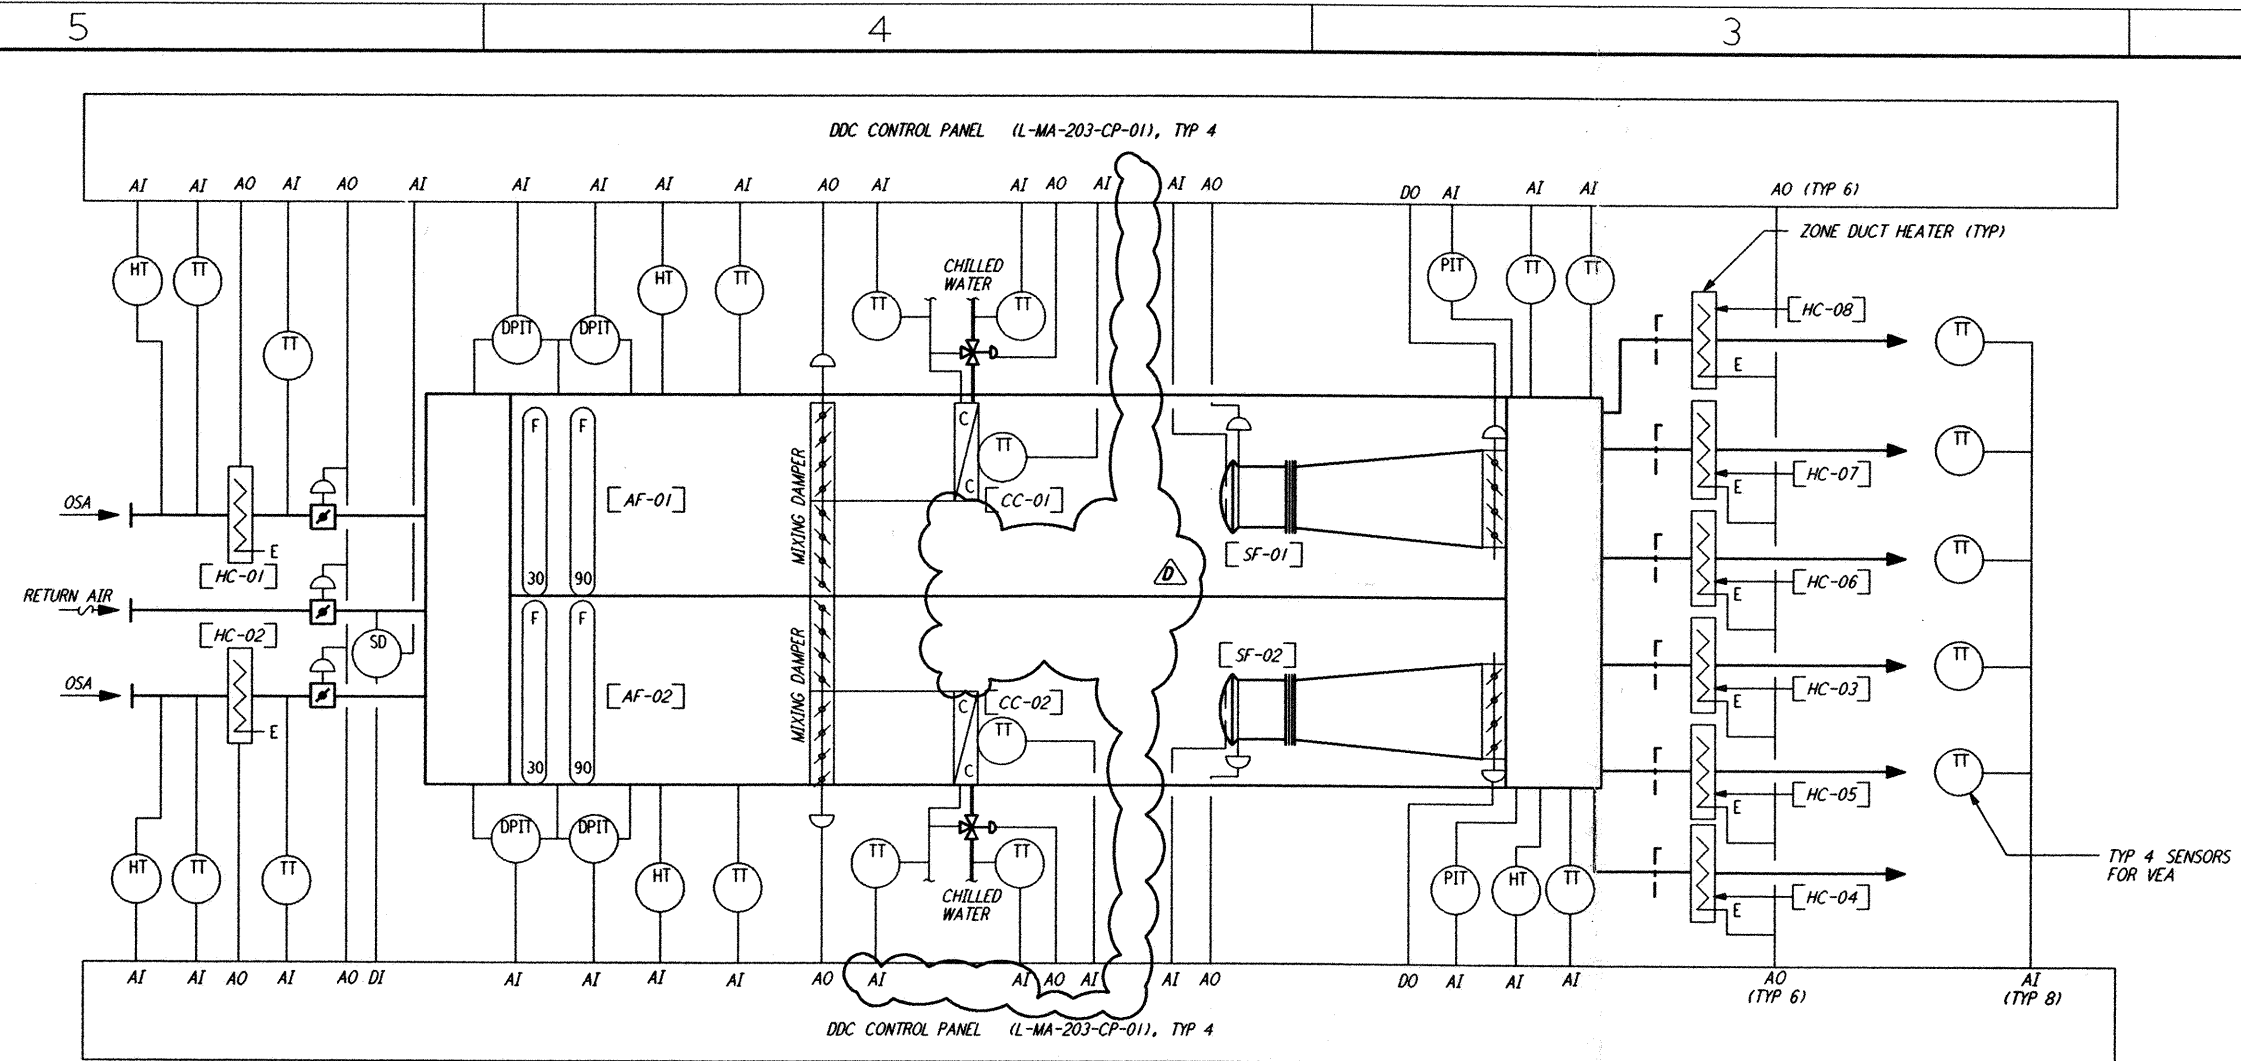

END STATION A CONTROL DIAGRAM
 (TYP FOR END STATION B)

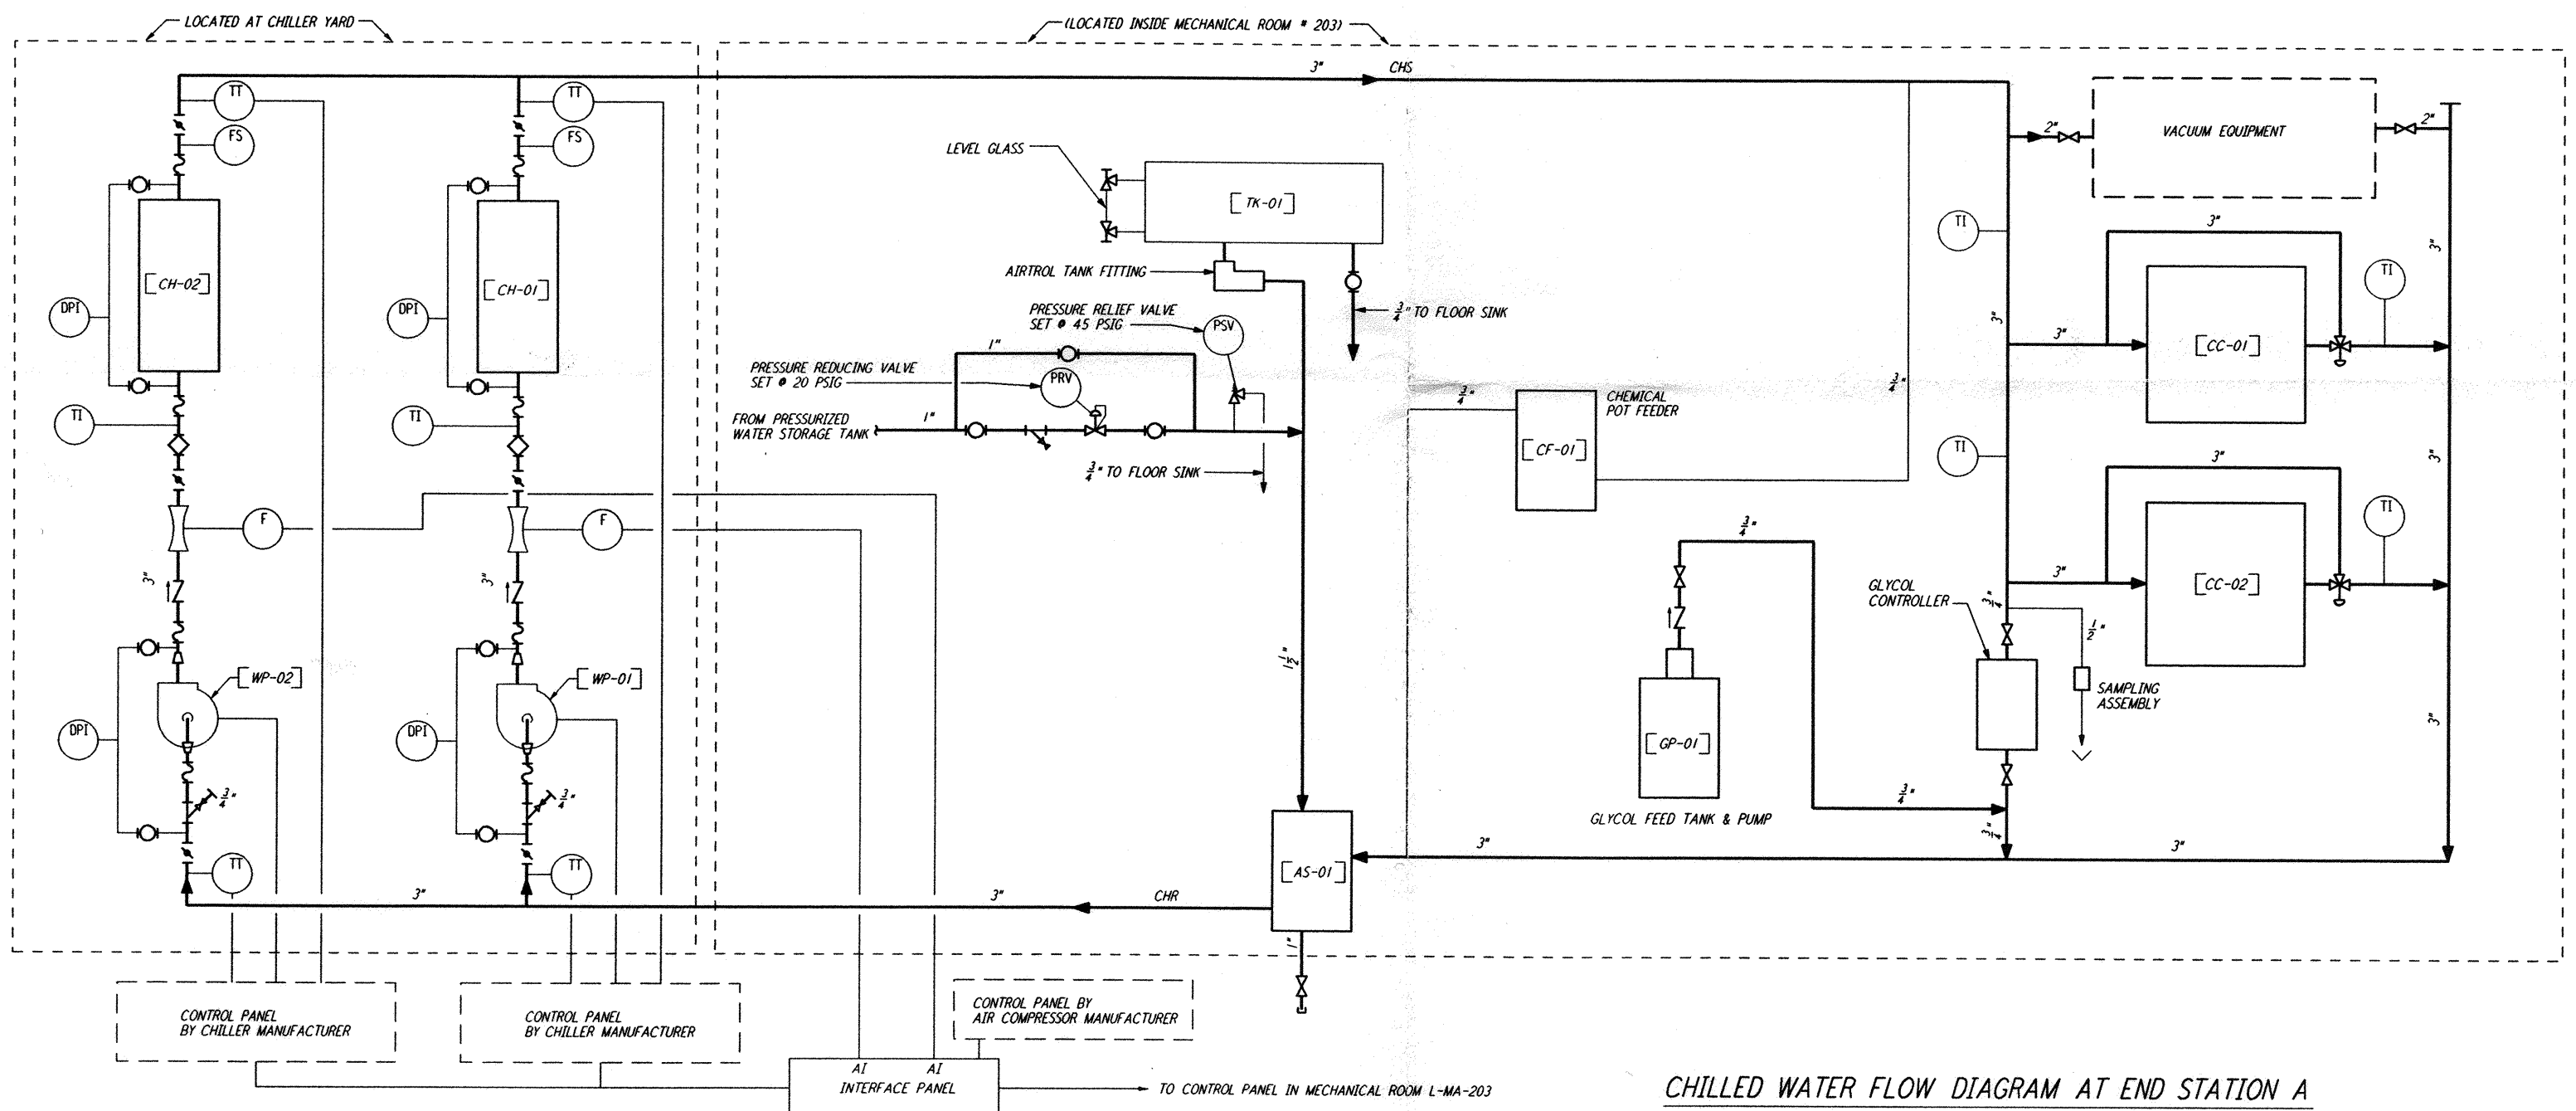

CHILLED WATER FLOW DIAGRAM AT END STATION A
 (TYP FOR END STATION B)

NO.	DATE	BY	CHKD	ENGR	PROJ	DESCRIPTION
D	9-10-96	CLP	ME	AA	TDM	BID ADDENDUM #2
C	7-24-96	CLP	ME	AA	TDM	ISSUED FOR BID
B	6-14-96	CLP	ME	AA	TDM	FINAL DESIGN REVIEW
A	10-31-95	CLP	ME	AA	TDM	PRELIMINARY DESIGN REVIEW

DRAWN	CLP
CHECKED	
ENGINEER	
PROJ	

PARSONS
 100 WEST WALNUT STREET
 PASADENA, CALIFORNIA

LIGO
 CALIFORNIA INSTITUTE OF TECHNOLOGY
 MASSACHUSETTS INSTITUTE OF TECHNOLOGY

LASER INTERFEROMETER
 GRAVITATIONAL-WAVE OBSERVATORY
 SITE NO. 2 - LIVINGSTON, LOUISIANA

TITLE	SCALE	CONTRACT NUMBER	PROJECT NUMBER
HVAC END STATION CHILLED WATER & AIR FLOW DIAGRAMS	NONE	PP150969	8094
SHEET NUMBER		REVISION	
LA-H-221			