

ELEVATION

DWG. NO.	DESCRIPTION	DWG. NO.	DESCRIPTION
V049-0-016	P & ID RIGHT MID STATION		
V049-0-006	P & ID BOK CRYOPUMP		
V049-5-017	PIPING ARRANGEMENT PLAN RIGHT MID STATION		
V049-5-004	EQUIPMENT ARRANGEMENT RIGHT MID STATION		
100103	LIGD VACUUM EQUIPMENT MID STATION		

UNLESS OTHERWISE SPECIFIED DIMENSIONS ARE IN INCHES
 TOLERANCES
 DO NOT SCALE THIS DRAWING
 USED ON: _____
 NEXT ASS'Y: _____

REV	DESCRIPTION	CHKD	DRWN	DATE	BY
3	REISSUED FOR CONSTRUCTION AS NOTED			06.06.97	0491
2	ISSUED FOR CONSTRUCTION			04.28.97	0440
1	ISSUED FOR FIR UPDATE & BID			12/23/96	0356
0	ISSUED FOR FIR			4/30/96	0133


PROCESS SYSTEMS INTERNATIONAL INC.
 30 WILKIN DR. WESTBOROUGH, MASSACHUSETTS 01581 USA

PIPING ARRG'T - ELEVATION (LEFT)
 RIGHT MID STATION
 WASHINGTON SITE
 LIGD VACUUM EQUIPMENT

DWG FILE: V0495018/3018S1
 SHEET: D
 REV: 3


SCALE: 3/8"=1'-0"
 SHEET: 1 OF 2

Jun 13, 1997 - 12:21:51

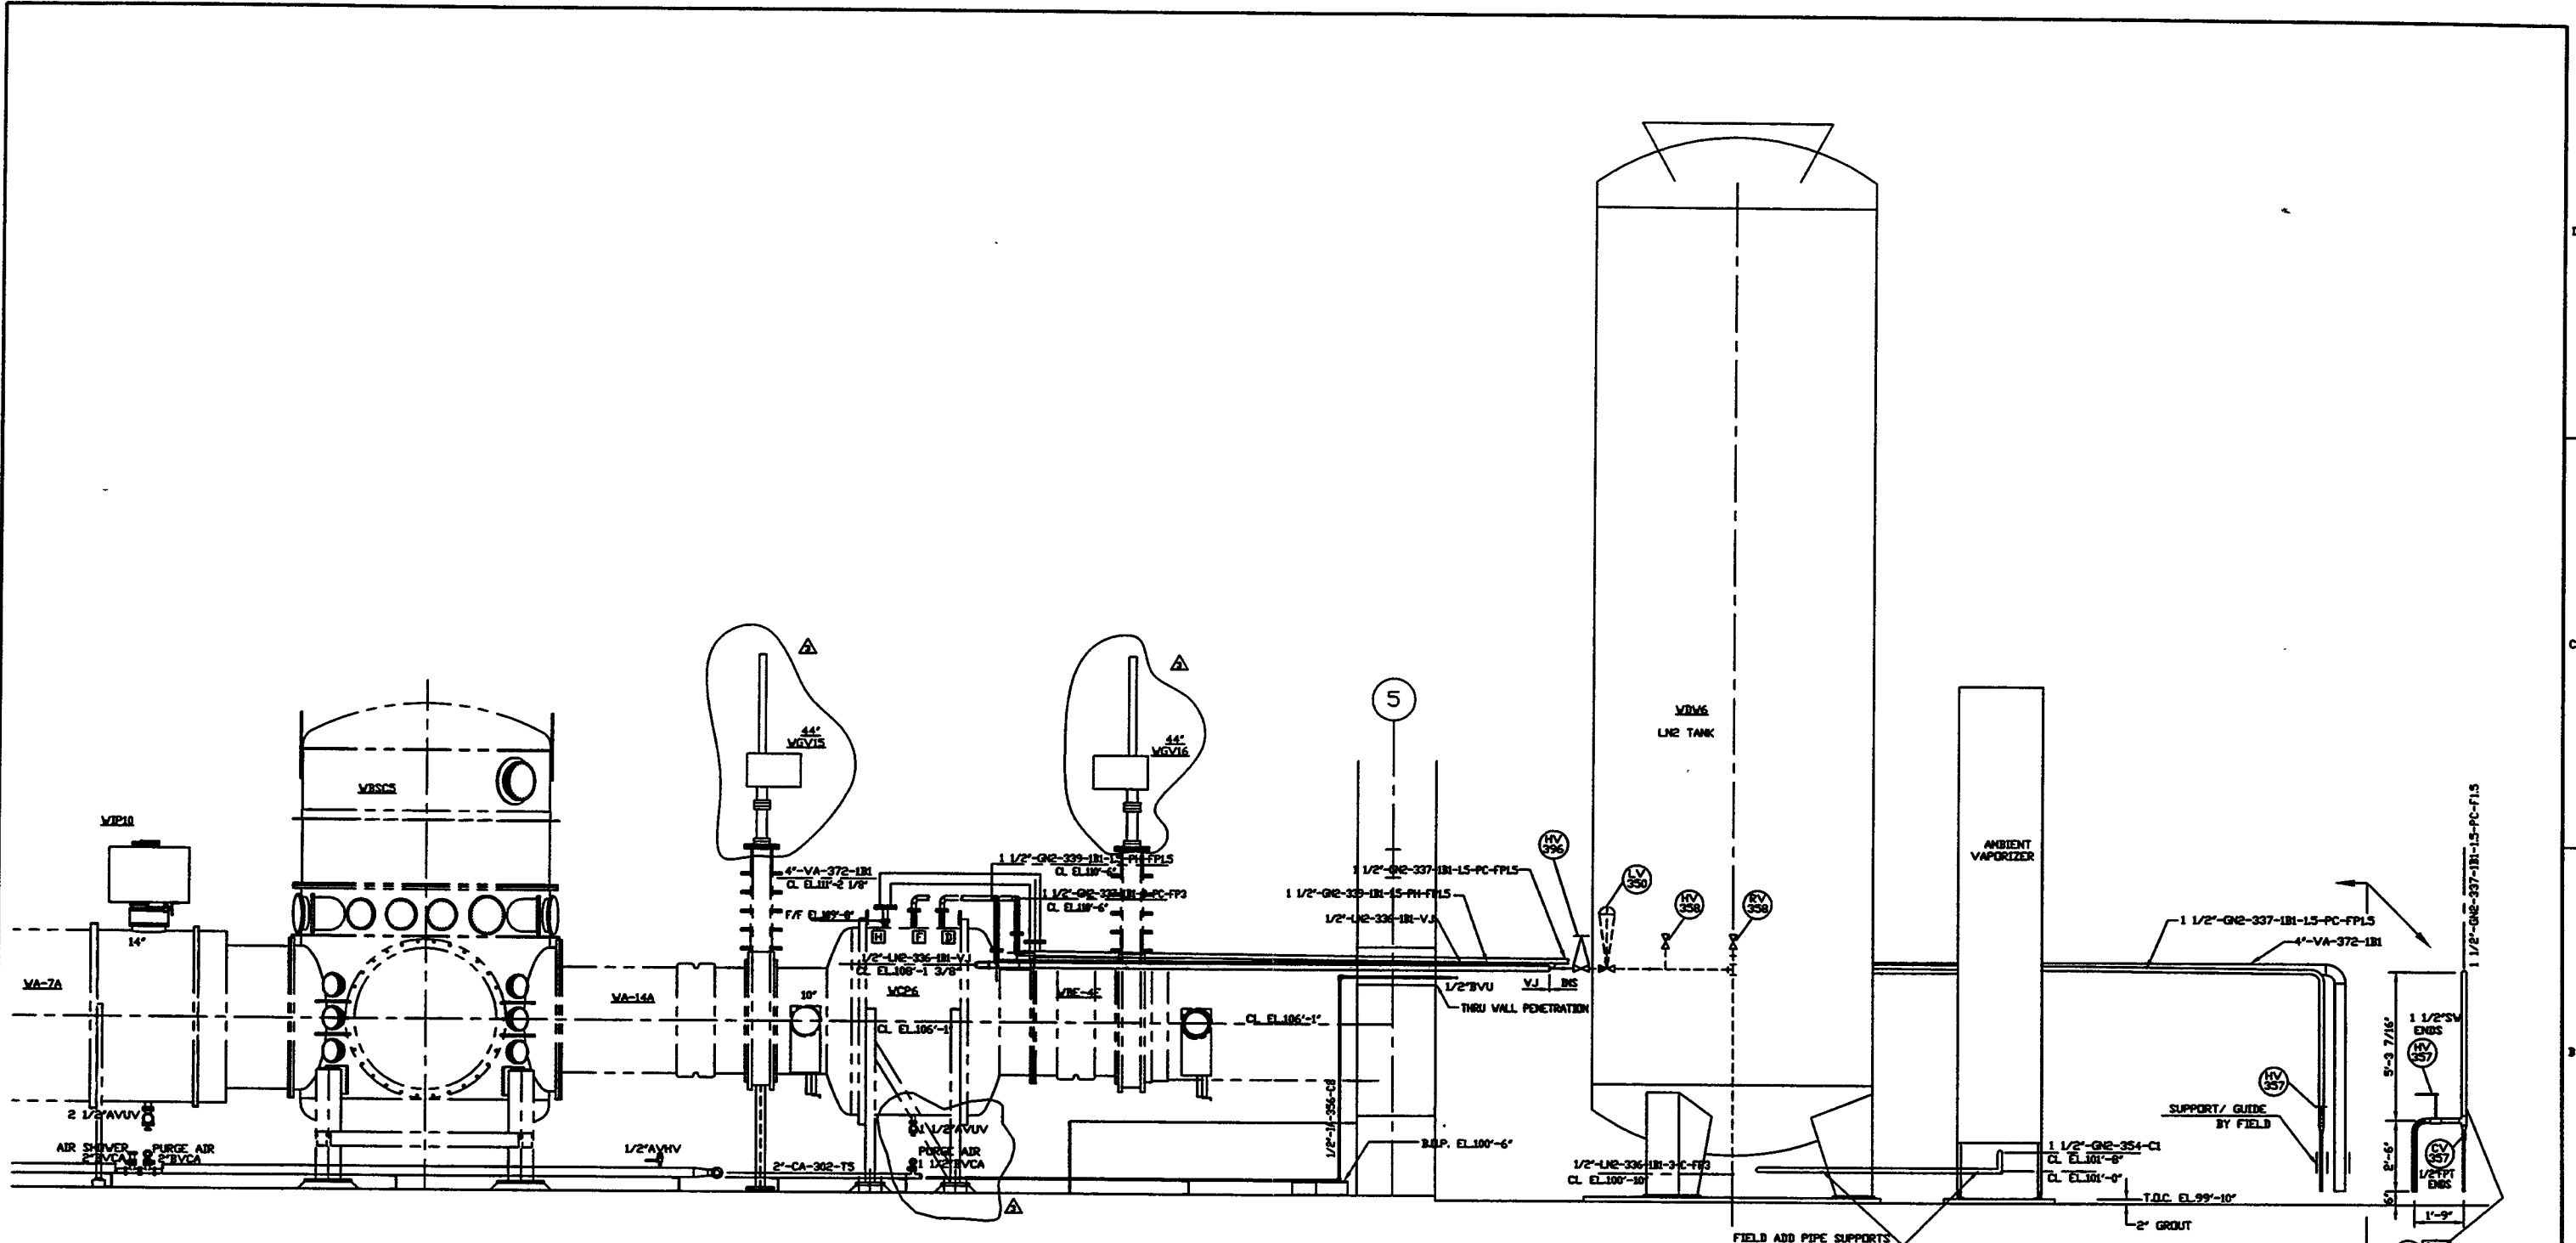

ELEVATION

SEE SHEET 1 FOR REVISIONS

 PROCESS SYSTEMS INTERNATIONAL INC. 20 WALKUP DR. WESTBOROUGH, MASSACHUSETTS 01581 USA			
PIPING ARRGT - ELEVATION (RIGHT) RIGHT MID STATION WASHINGTON SITE LIGO VACUUM EQUIPMENT			
CAD FILE	SIZE	DWG. NO.	REV.
V0495018/5018S2	D	V049-5-018	3
SCALE	SHEET		2 OF 2
3/8"=1'-0"			

JAN 13, 1997 - 182603