




PLAN AT TYPICAL BAY

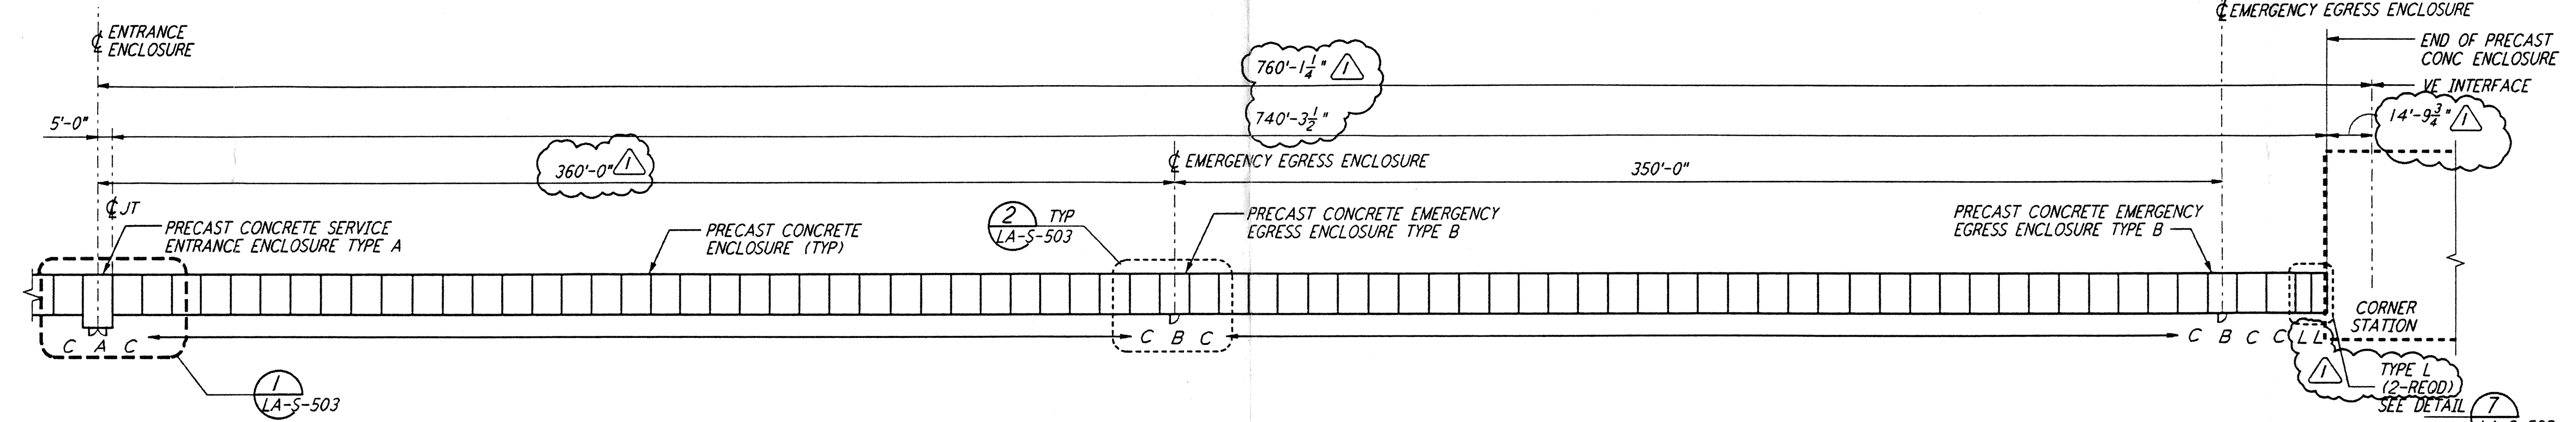


PLAN AT CORNER STATION

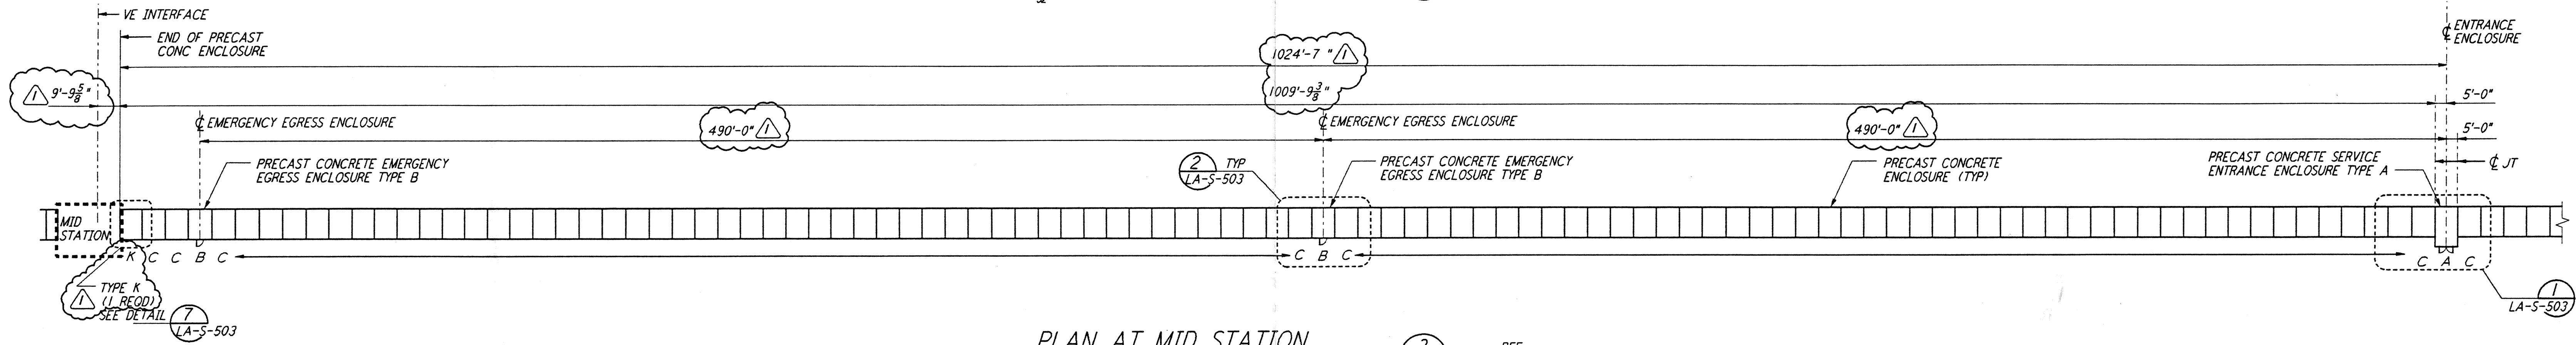

PLAN AT MID STATION

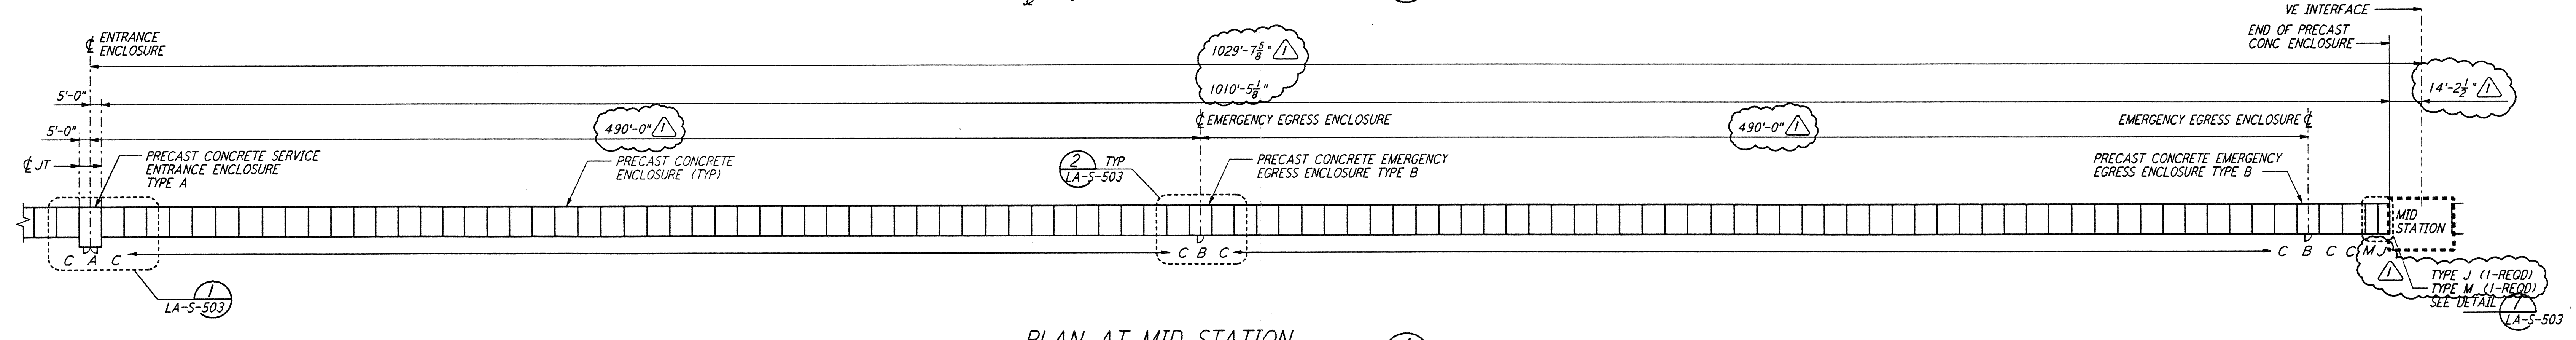


PLAN AT MID STATION

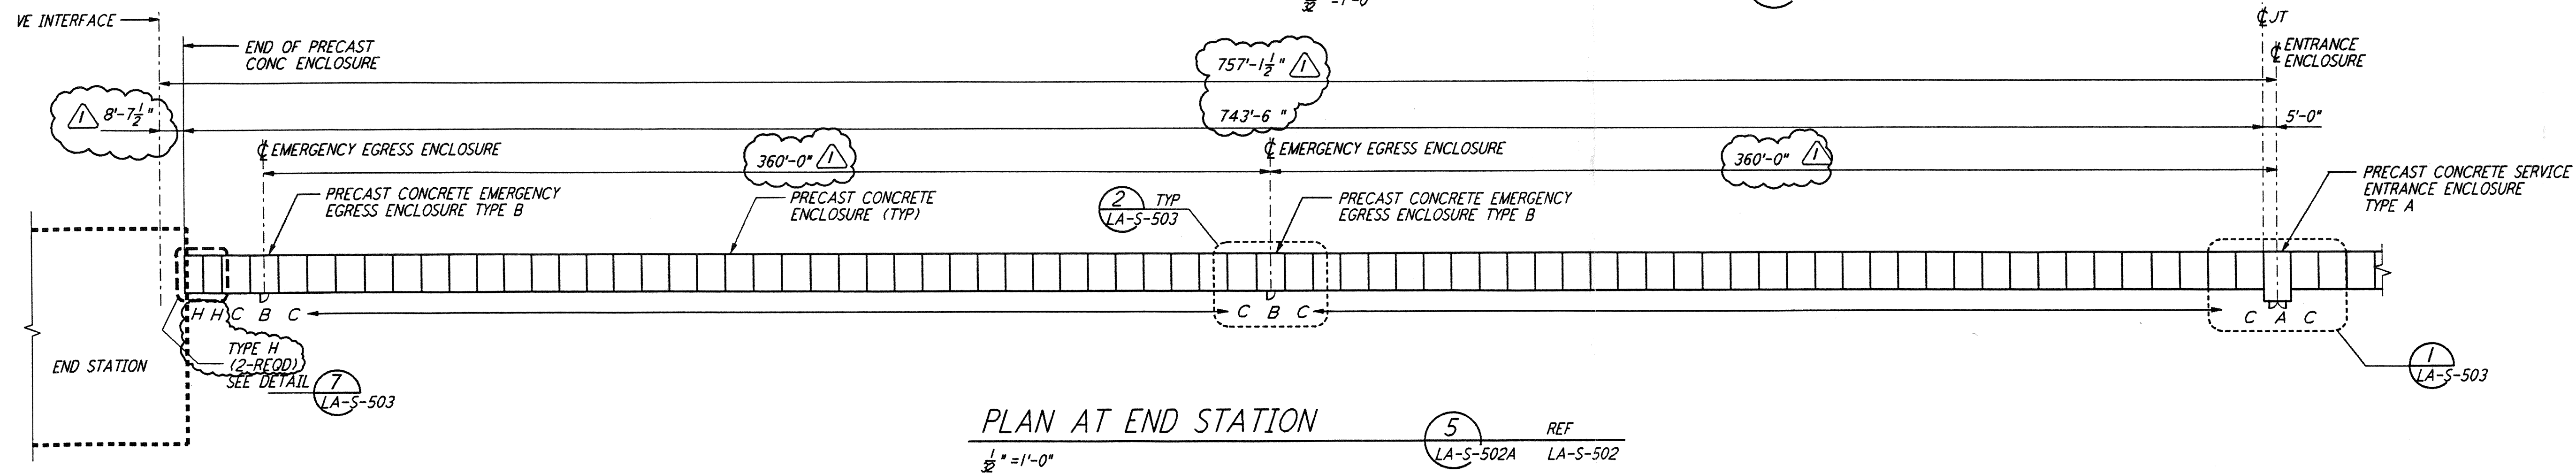

PLAN AT END STATION



NOTE:
 1. FOR GENERAL NOTES, ABBREVIATIONS AND LEGEND SEE DRAWING LA-S-501.

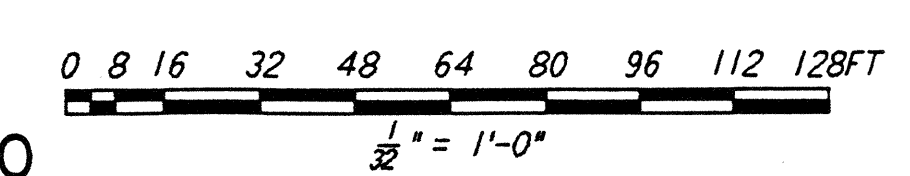

This document and the design it covers are the property of PARSONS. They are loaned only with the borrower's expressed written agreement that they will not be reproduced, copied, loaned, exhibited, or used in any other way, except by written consent from PARSONS to the borrower.

REV. NO.	DATE	BY	CHKD	ENGR	PROJ	DESCRIPTION
1	2-28-97	GP	GP	GP	GP	REV DIMENSIONS & ENCLOSURE TYPES

ISSUED FOR CONSTRUCTION	
DRAWN	MCS 11-15-96
CHECKED	DDM 11-15-96
ENGINEER	BP 11-15-96
PROJ	TDM 11-15-96

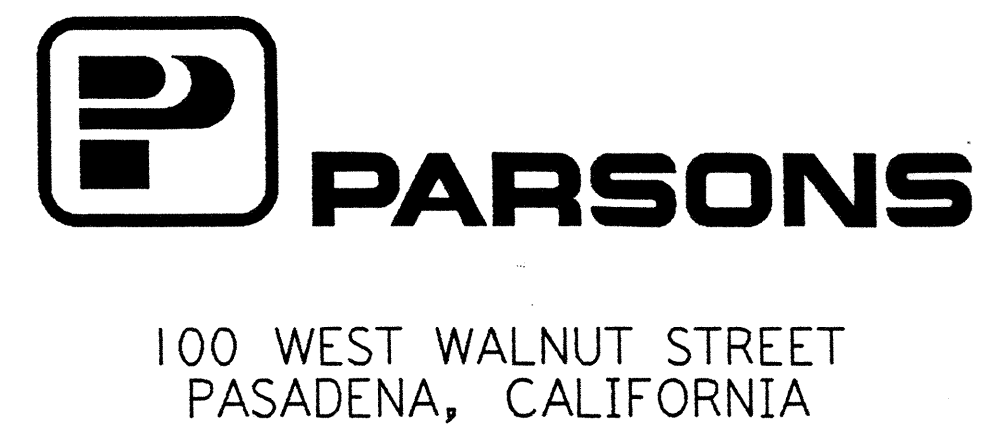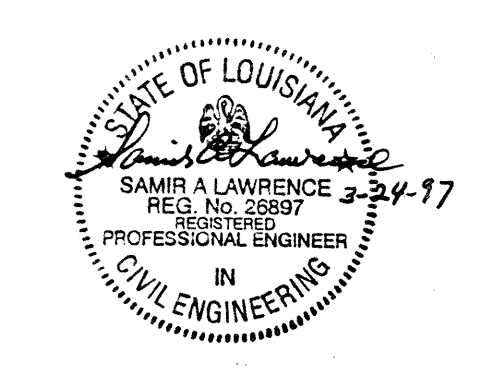

LASER INTERFEROMETER GRAVITATIONAL-WAVE OBSERVATORY BEAM TUBE ENCLOSURE - LIVINGSTON, LA		
TITLE	SCALE	CONTRACT NUMBER
STRUCTURAL SOUTH EAST ARM BEAM TUBE ENCLOSURE PARTIAL ENLARGED PLANS	AS NOTED	PP150969
	SHEET NUMBER	PROJECT NUMBER
LA-S-502A		8094