
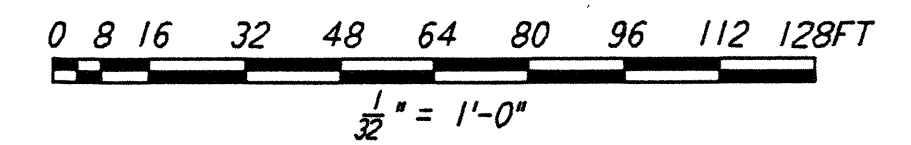


not be reproduced, copied, loaned, exhibited, or used in any other way, except by written consent from PARSONS to the borrower.


This document and the design it covers are the property of PARSONS. They are loaned only with the borrower's expressed written agreement that they will

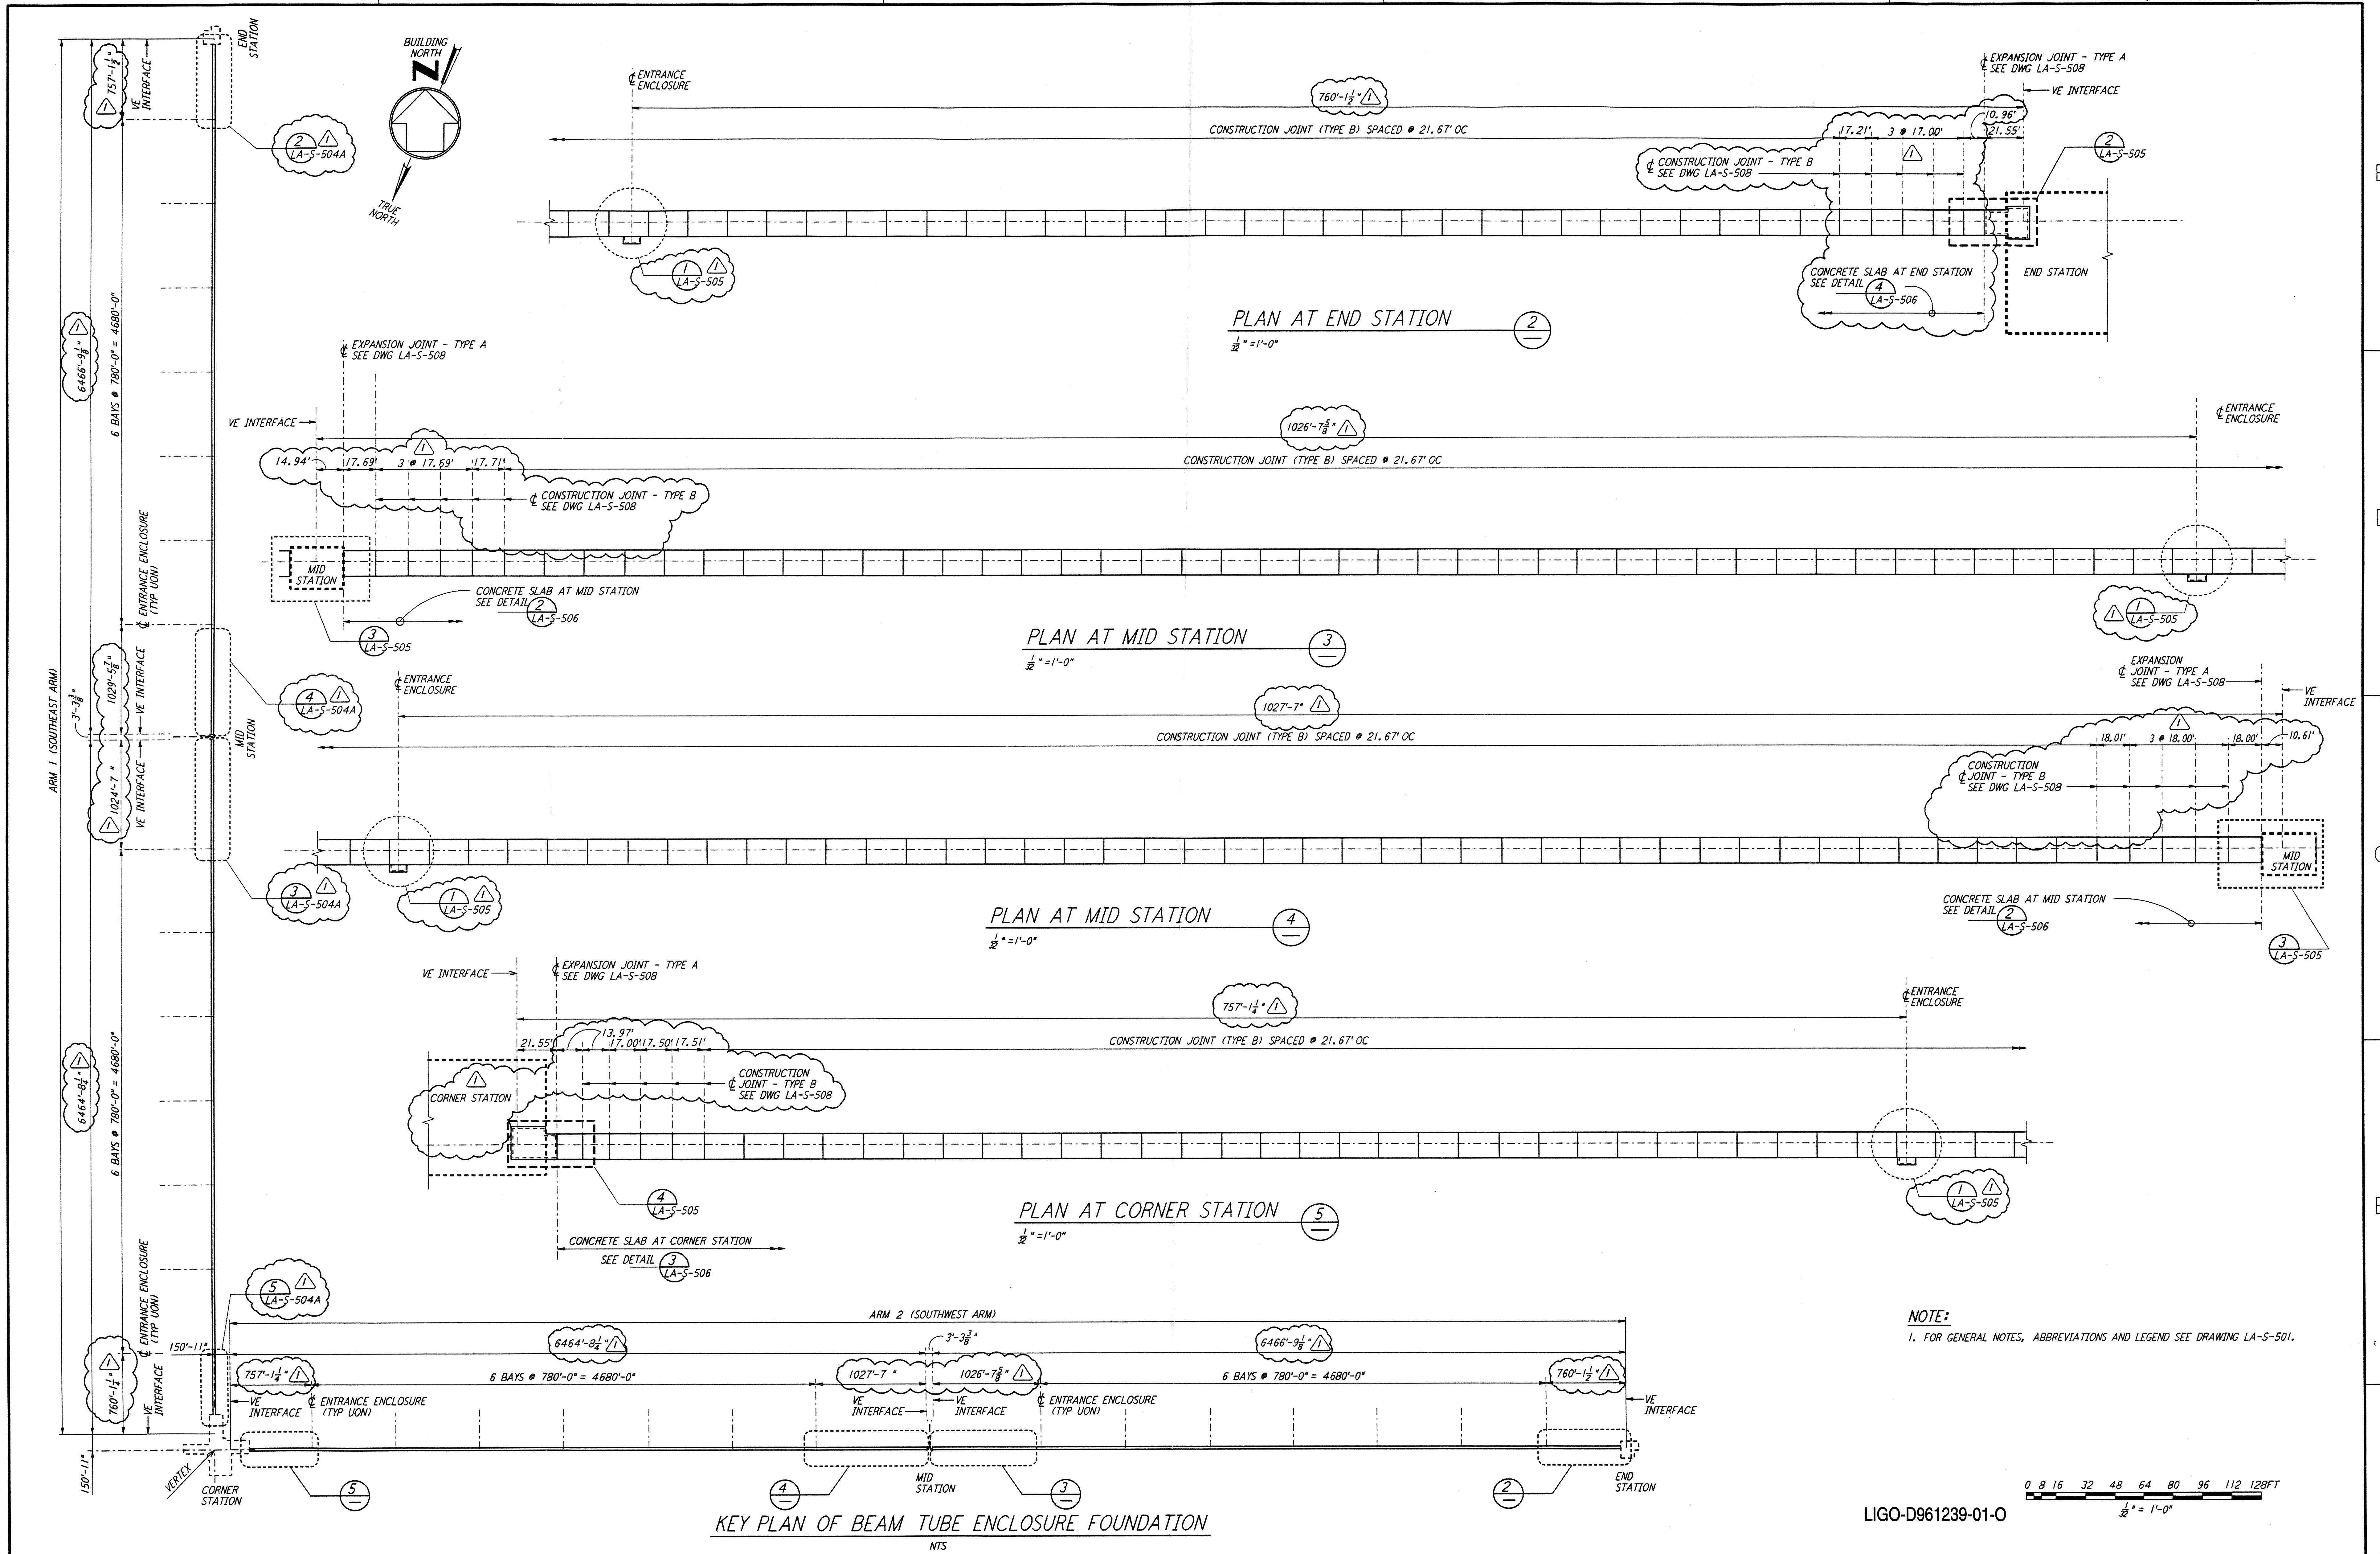

LIGO-D961239-01-0

NO.	DATE	BY	CHKD	ENGR	PROJ	REV DIMENSIONS & DET REFS	DESCRIPTION
1	2-28-97	GP	DDM	GP	DDM		

ISSUED FOR CONSTRUCTION			
DRAWN	MCS	11-15-96	
CHECKED	DDM	11-15-96	
ENGINEER	BP	11-15-96	
PROJ	TDM	11-15-96	

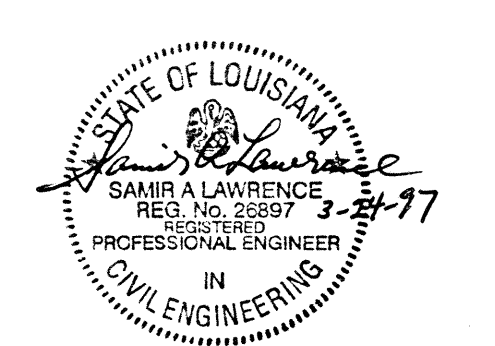

**PARSONS**  
 100 WEST WALNUT STREET  
 PASADENA, CALIFORNIA

**LIGO**  
 CALIFORNIA INSTITUTE OF TECHNOLOGY  
 MASSACHUSETTS INSTITUTE OF TECHNOLOGY

LASER INTERFEROMETER  
 GRAVITATIONAL-WAVE OBSERVATORY  
 BEAM TUBE ENCLOSURE - LIVINGSTON, LA

STRUCTURAL  
 KEY PLAN OF BEAM TUBE  
 ENCLOSURE FOUNDATION &  
 PARTIAL ENLARGED PLANS

SCALE AS NOTED  
 CONTRACT NUMBER PPI50969  
 PROJECT NUMBER 8094  
**LA-S-504**