





- NOTES:**
- SEE SHEET LA-C-502 FOR GENERAL NOTES, LEGEND AND ABBREVIATIONS.
  - SEE SHEET LA-C-504 FOR TYPICAL SECTIONS AND DETAILS.

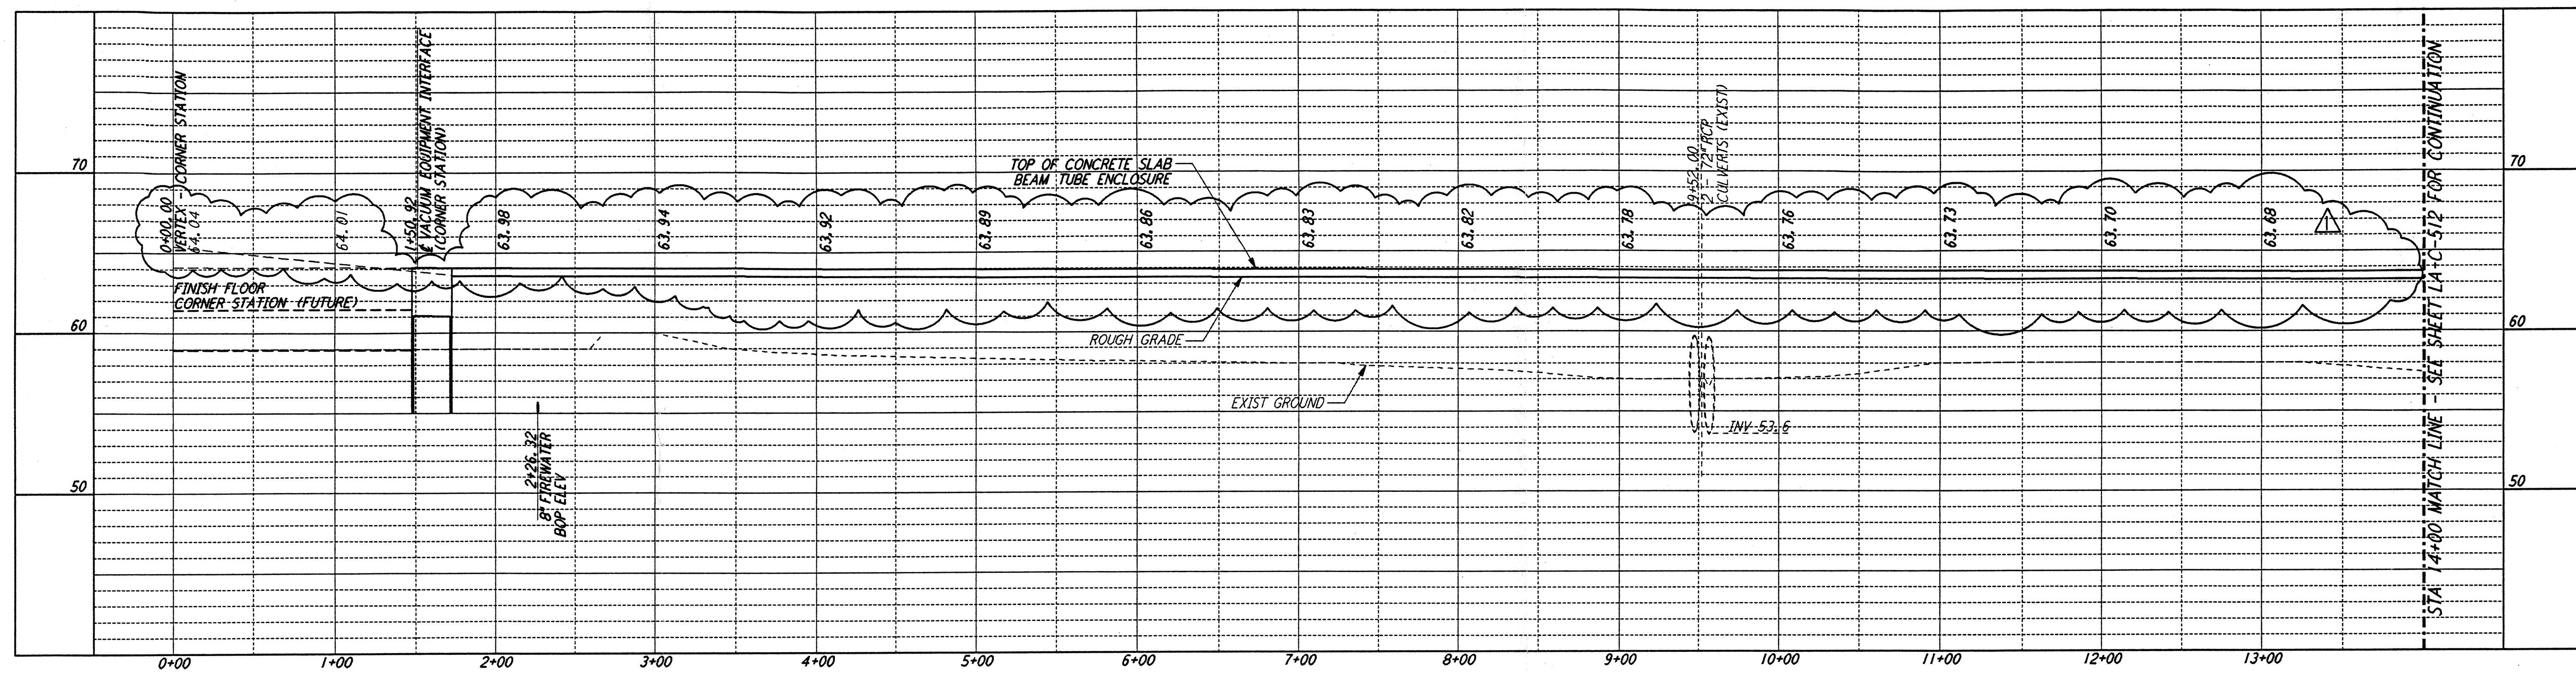

**PROFILE**  
 SCALES: HORIZ: 1" = 50'  
 VERT: 1" = 5'

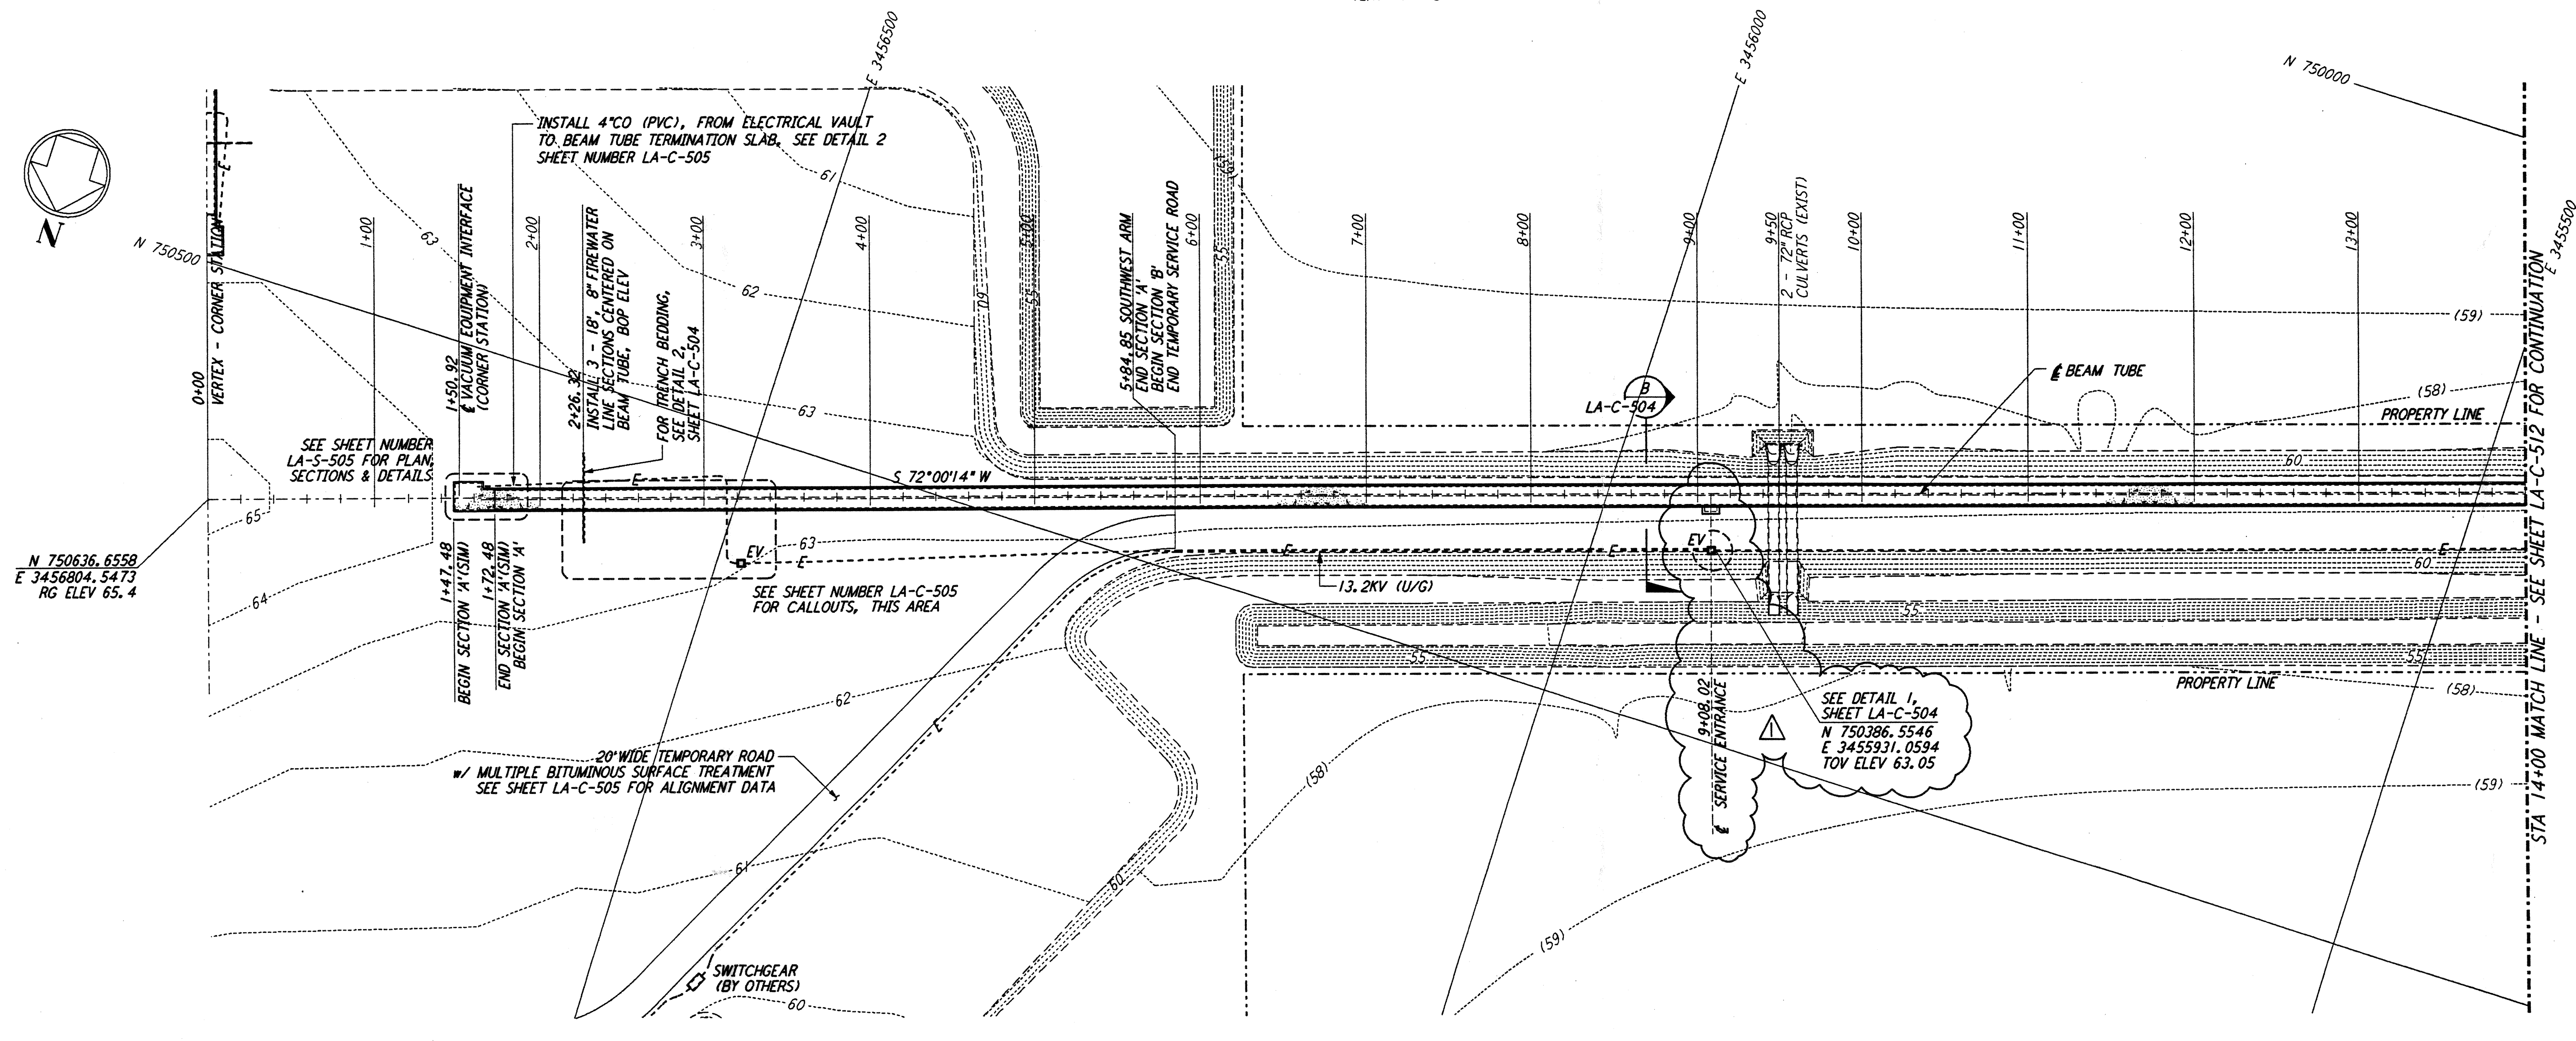


**PLAN**  
 SCALE: 1" = 50'

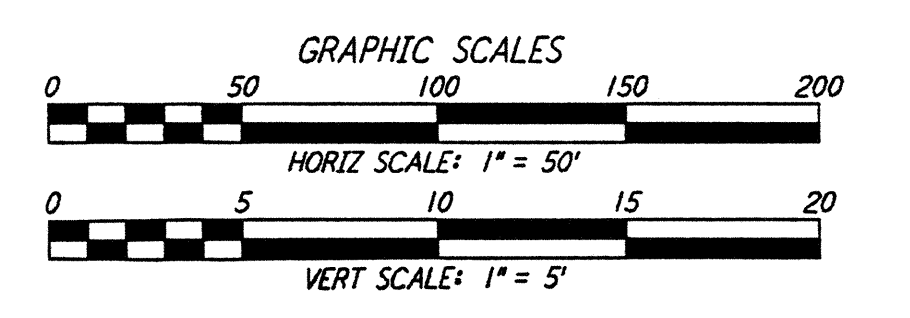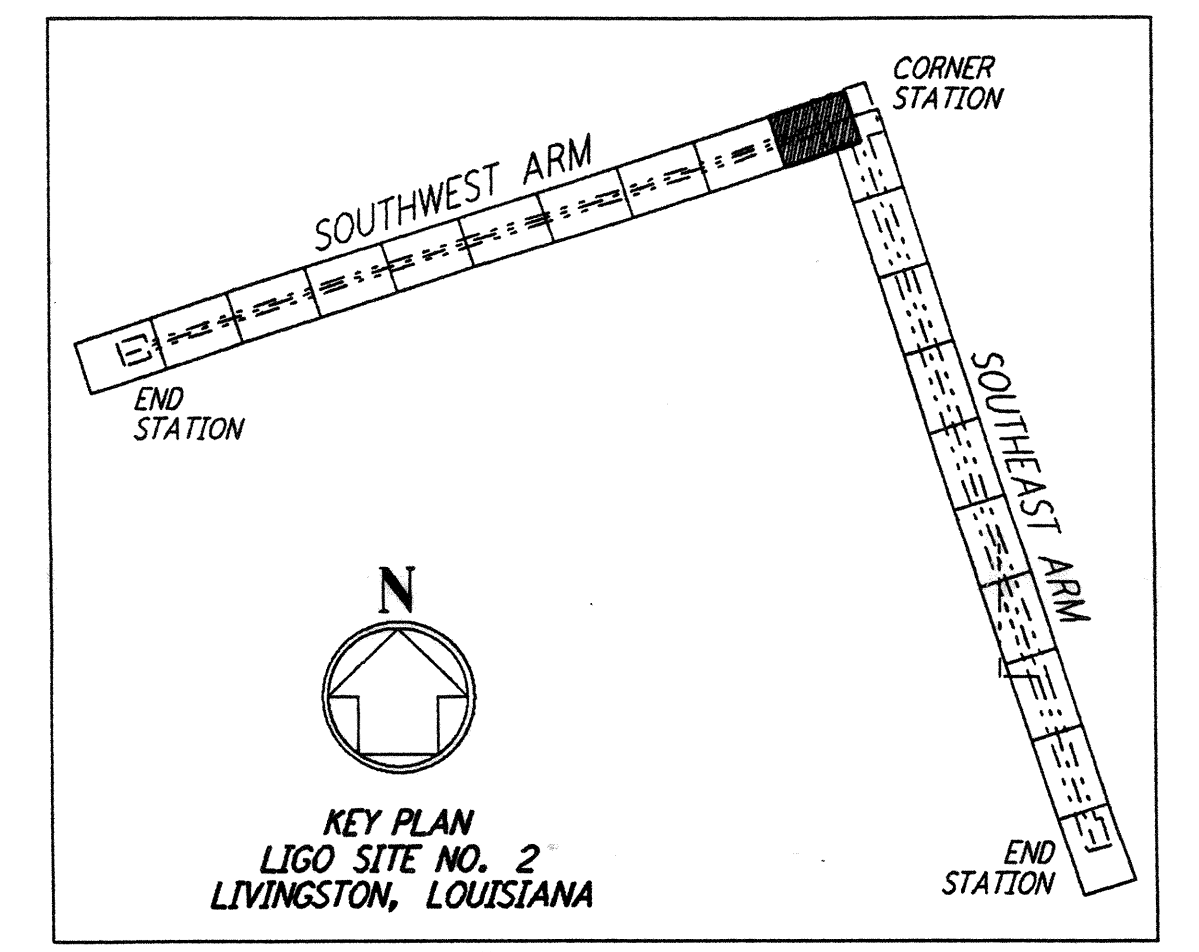

This document and the design it covers are the property of PARSONS. They are loaned only with the borrower's expressed written agreement that they will not be reproduced, copied, loaned, exhibited, or used in any other way, except by written consent from PARSONS to the borrower.

| NO. | DATE   | BY  | CHKD | ENGR | PROJ | DESCRIPTION  |
|-----|--------|-----|------|------|------|--|
| 1   | 2-3-97 | WRB | CL   | JIS  | TDM  | REVISED SERVICE ENTRANCE, ELEC VAULT, PROFILE ELEV |

| ISSUED FOR CONSTRUCTION |     |          |
|-------------------------|-----|----------|
| DRAWN                   | WRB | 11-15-96 |
| CHECKED                 | ML  | 11-15-96 |
| ENGINEER                | JB  | 11-15-96 |
| PROJ                    | TDM | 11-15-96 |

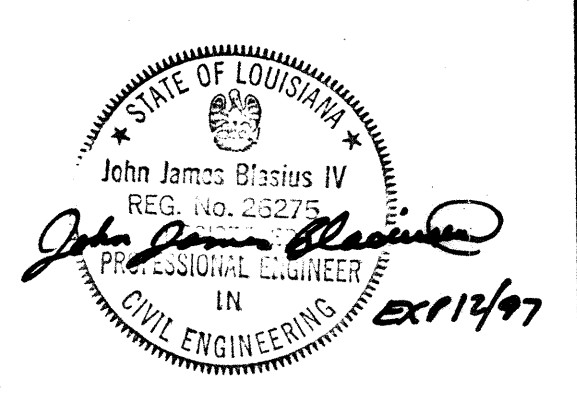

**PARSONS**  
 100 WEST WALNUT STREET  
 PASADENA, CALIFORNIA

**LIGO**  
 CALIFORNIA INSTITUTE OF TECHNOLOGY  
 MASSACHUSETTS INSTITUTE OF TECHNOLOGY

LASER INTERFEROMETER  
 GRAVITATIONAL-WAVE OBSERVATORY  
 BEAM TUBE ENCLOSURE - LIVINGSTON, LA

TITLE: CIVIL SOUTHWEST ARM PLAN AND PROFILE STA 0+00 TO STA 14+00

SCALE: AS NOTED CONTRACT NUMBER: PPI50969 PROJECT NUMBER: 8094

SHEET NUMBER: **LA-C-511**